


FILED
 GREENVILLE CO. S. C.
 JUL 21 2 14 PM '83
 DONNIE S. TANKERSLEY
 R.M.C.

This is to certify that on July 19, 1983, I surveyed the property shown on this plat, known as Lot 167 on the plat of Heritage Lakes, recorded in the RMC Office of Greenville County in Plat Book 6H on page 17 and that the property lines, walls and buildings are as shown hereon; that the building located on said lot does not encroach or project on adjacent streets or property and that no adjacent walls or buildings encroach or project on said premises, and that no utility lines cross this property except as shown hereon.

Except where shown otherwise, ALL lots to have 10' utility and drainage easement along side and rear lot lines.

James R. Freeland
 James R. Freeland P.E. and RES
 2243
 9-V-57 JUL 21 1983

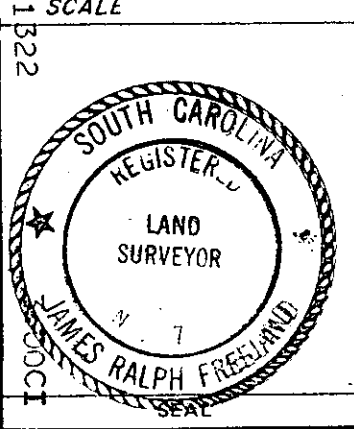

STATE OF SOUTH CAROLINA
GREENVILLE COUNTY

HERITAGE LAKES
LOT 167
 PROPERTY OF
LARRY J. CARPENTER
DEBORA A. CARPENTER

FREELAND & ASSOCIATES Engineers • Land Surveyors	
GREENVILLE, S.C.	
SURVEY	J.C.
DRAWN	K.E.G.
CHECK	<i>M</i>
SCALE	1" = 50'
DATE	7-19-83
DWG. NO.	9373