


MICROFILMED

FILED
GREENVILLE CO. S. C.
JUL 25 9 09 AM '83
DONNIE S. TANKERSLEY
R.M.C.

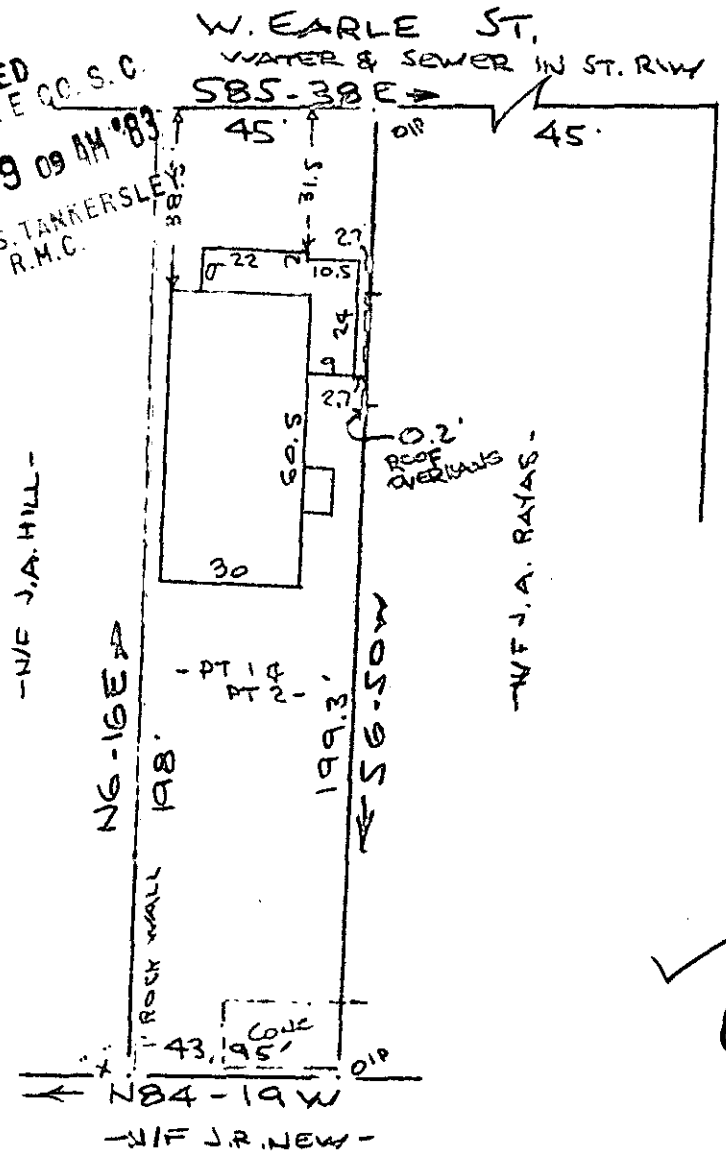

ROBINSON ST.

Note: Improvements on this lot are not in a flood hazard area.

JUL 25 1983



9V-70

PROPERTY OF
 ALLEN R. STOGNER & SARA W. STOGNER
 GREENVILLE, S. C.
 40' 21 JULY 0 1983 40'

2713

This is to certify that on the 21st day of July, 1983, I surveyed the property shown on this plat, being known as part of lot 1 and part of 2 on plat of FLORIDE G. KILMER and recorded in the US Office Greenville County, S. C., in Plat Book "2" at Page 99; and that the property lines, walls and buildings are as shown hereon, and that the walls and buildings located on said lot do not encroach or project on adjacent street or property, and that no adjacent walls or buildings encroach or project on said premises, and no power lines cross this property except as shown hereon.

DAVID B. BRUCE
 B. C. BRUCE, RLS #1952
 A. B. SURVEYOR
 B. BRUCE

CAROLINA SURVEYING CO.
 112 Keady St.
 Greenville, S. C.