MICROFILMED

FILED
GREENVILLE CO. S. C.
JUL 25 3-15 PM '83
DONNIE S. TANKERSLEY
R.M.C.

NOTE: Improvements on this lot are not in a flood hazard area.

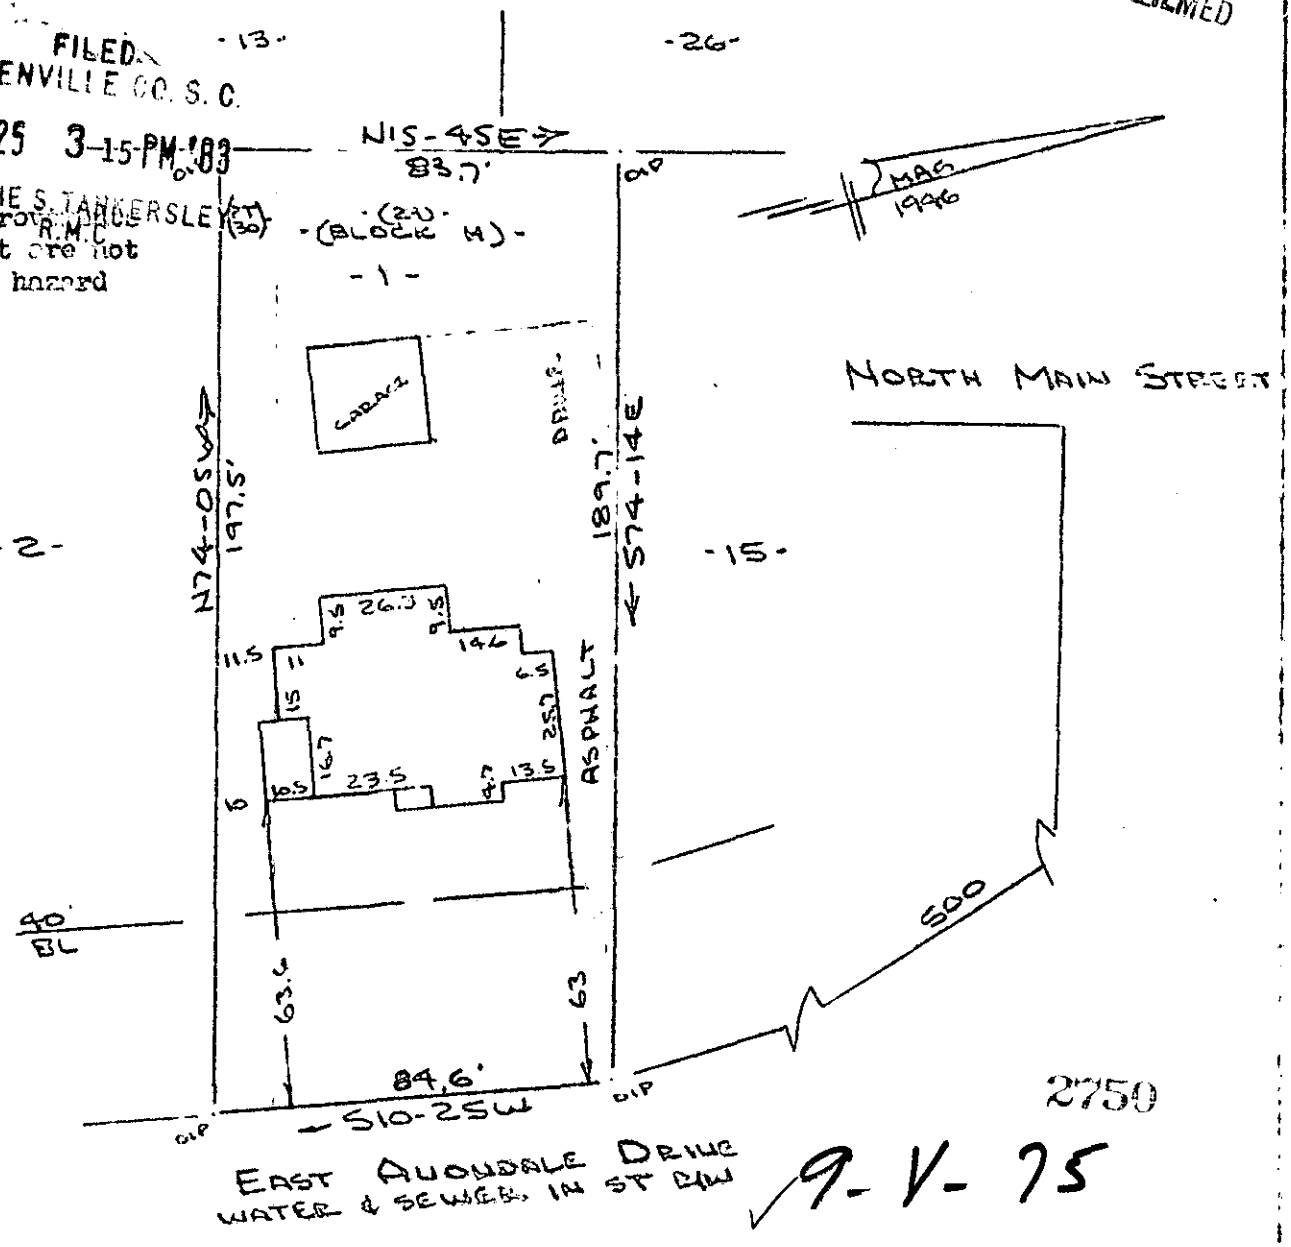

PROPERTY OF
MICHAEL C. YOST & ELLIS R. YOST
GREENVILLE, S.C.
13 JULY 1983

JUL 25 1983

40 20 0 40

This is to certify that on the 13th day of July, 1983, I surveyed the property shown on this plat, being known as lot 29 on plat of NORTHGATE and recorded in the RMC Office Greenville County, S. C., in Plat Book " B " at Page 181; and that the property lines, walls and buildings are as shown hereon, and that the walls and buildings located on said lot do not encroach or project on adjacent property, and that no adjacent walls or buildings encroach or project on said premises, and no power lines cross this property except as shown hereon, and also known as the property of MICHAEL C. YOST & ELLIS R. YOST recorded in Plat Book at Page .

CAROLINA SURVEYING CO.
112 Manly St.
Greenville, S. C.

R. Bruce Bruce R.L.S. 1952

STAMP ----2 JL25 83 413 3.00CI