
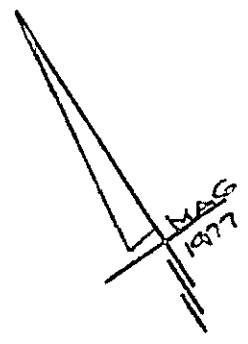


MICROFILMED

FILED
GREENVILLE CO., S. C.
JUL 29 4 37 PM '83
DONNIE S. TANKERSLEY
R.M.C.

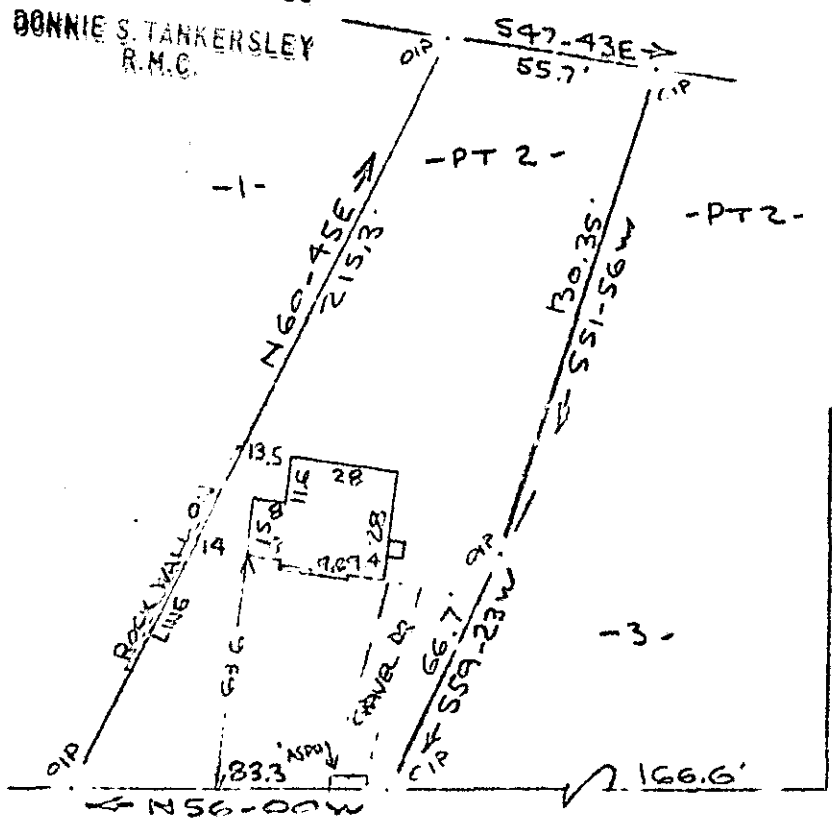

Note: Improvements on this lot are not in a flood hazard area.

POST OAK RD

MAULDIN RD (PARKINS' MILL RD)
WATER & SEWER IN ST. ROW

3476
9-V-99

PROPERTY OF
MICHAEL A. KEESE & STACY M. SPERAW
NEAR GREENVILLE, S.C.
40 27 JULY 1983 40
FILED

C., in "Lot Book" " " at Page 26; and that the property lines, walls and buildings are as shown hereon, and that the walls and buildings located on said lot do not encroach or project on adjacent street or property, and that no adjacent walls or buildings encroach or project on said property, and no power lines cross this property except as shown hereon.

R. B. [Signature]
SOUTH CAROLINA
REGISTERED SURVEYOR
1852

5010 - 2 JUL 29 83 994 3.00CI