- 1. ALL BUILDING LOCATION DIMENSION WERE MEASURED TO BUILDINGS IN FIELD.
- 2. ALL INTERIOR ANGLES IN UNITS ARE 90 UNLESS OTHERWISE NOTED.
- 3. EASEMENTS EXIST TO DUKE POWER CO., SOUTHERN BELL TEL. CO. FOR SERVICE LINES TO BUILDINGS.
- 4. EACH UNIT CONSISTS OF THE SPACE BOUNDED BY THE UNDERCOATED AND UNFINISHED SURFACES OF THE PERIMETER WALLS, FLOORS, AND CEILINGS.
- 5. SEE ADDITIONAL SHEETS FOR FLOOR PLANS
- 6. UNIT BOUNDRY ----

LEGEND

W.M.

S.S.

N.H.

C.O.

F. HYD.

WATER LINE

POWER LINE

WATER METER

MAN HOLE

FIRE HYD


I.RON PIPE

CLEAN OUTS

STORM SEWER

- 7. LIMITED COMMON AREAS ////////////
- 8 ALL AREAS NOT SHOWN WITHIN THE UNIT BOUNDRY OR AS LIMITED COMMON AREA ARE TO BE CONSIDERED AS COMMON ARES. -

GREENVILLE OF S. C. SEP 22 | 1 19 AM *83 DONNIE STEAMS ERSLEY R.M.C

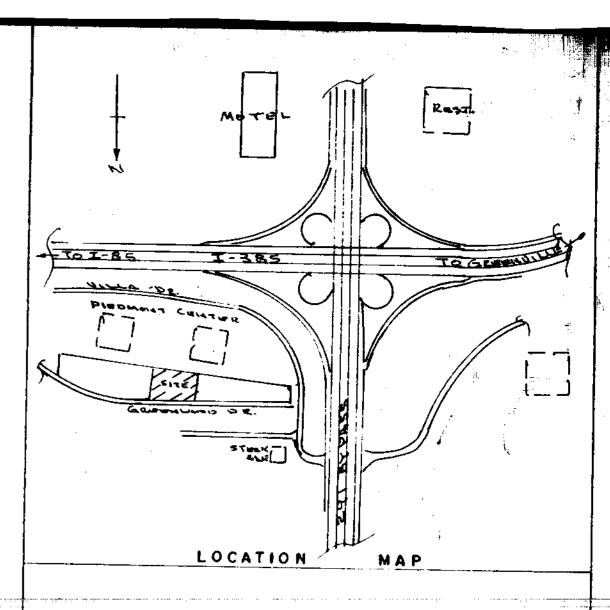

FINAL PLAT OVERHEAD POWER CROSSTIE RET WALL 7 131.3 CERTIFICATE OF OWNERSHIP AND DEDICATION "The undersigned hereby acknowledge that I am (we are) the owner(s) of the property shown and described hereon and that I (we) hereby adopt this plan of subdivision with my (our) free consent and that I (we) establish the minimum building restriction lines, and hereby dedicate on said plat. PLRKING UNIT UNIT AREA 15.0 29.8 # F 8 " SANITARY SEWER CERTIFICATE OF ACCURACY 30,62

THIS PLET IS NOT A SUBDIVISION COUNTY SULDIVISION REGULATIONS. 122183 Fet Fale

THE DRIVE, PARKING AND ALL PAVED AREAS SHOWN ARE

PROPERTY REGIME AS PERMANENT, EXCLUSIVE EASEMENT

THE PURPOSE OF MAINTAINING, REPLACING AND REPAIRING

PRIVATE WITHIN THE GREENLAND DRIVE HORIZONTAL

FOR THE OWNERS OF THE PROPERTY REGIME, AND FOR

GREENLAND DRIVE

UTILITIES.

Plat Filed This 22 day of A set 1983

And Recorded in Vol. 9-12 Page 36 at 1498 M

Danie 3. Jank Makeny

THIS IS TO CERTIFY THAT I SURVEYED THE PROPERTY SHOWN ON THIS PLAT, AND THAT THE PROPERTY LINES AND BUILDINGS ARE AS SHOWN HEREON, THAT THE BUILDING LOCATED ON SHOWN PROPERTY DO NOT ENCROACH OR PROJECT ON ADJACENT STREET OF PROPERTY, AND THAT NO ADJACENT BUILDINGS OR WALLS ENCROACH OR PROJECT ON SHOWN PROPERTY.

S.C.REG. NO. 4035

9-W-36

certify that this plat was (drawn by me) (drawn
under my supervision) (an actual survey made under my supervision) from (an actual survey
made by me) (deed description recorded in Pook 1100 poor -0.10
Book Rage , etc.) (other); that the error of closure as calculated by
atitudes and departures is 1) e.e.e., that the boundaries not surveyed are shown
is broken lines plotted from information found in Book, Page, that
his plat was prepared in accordance with the Greenville County Subdivision Regulations is adopted.
a duopieu.

9/2/83	Keemil 7. A.
DATE	LICENSED ENGINEER OF REGIS

STERED SURVEYOR S.C. Registration No. __4 0 3 5

CERTIFICATE OF APPROVAL FOR RECORDING

"I hereby certify that the subdivision plat shown hereon has been found to comply with the Subdivision Regulations for Greenville County, with the exception of such variances, if any, as are noted in the minutes of the Greenville County Planning Commission of Greenville County, South Carolina, and that it has been approved for recording in the office of the County Register of Mesne Conveyance."

DIRECTOR OF PLANNING
GREENVILLE COURTY PLANNING COMMISSION

FILE NUMBER

GREENLAND DRIVE HORIZONTAL PROPERTY

W. WILLIAM BASHOR, JR.

ENGINEER OR SURVEYOR JOHN F. PALMER OWNER

NO. OF ACRES: 0, 25

MILES OF NEW ROADS: _________

NO. OF LOTS: 1

DATE: 9/2/83

ZONE: E

SCALE: 1" = 20

9777