AF 10755A

FILED
GREENVILLE CO. S. C.
AUG 1 11 01 AM '83
DONNIE S. TANKERSLEY
R.M.C.

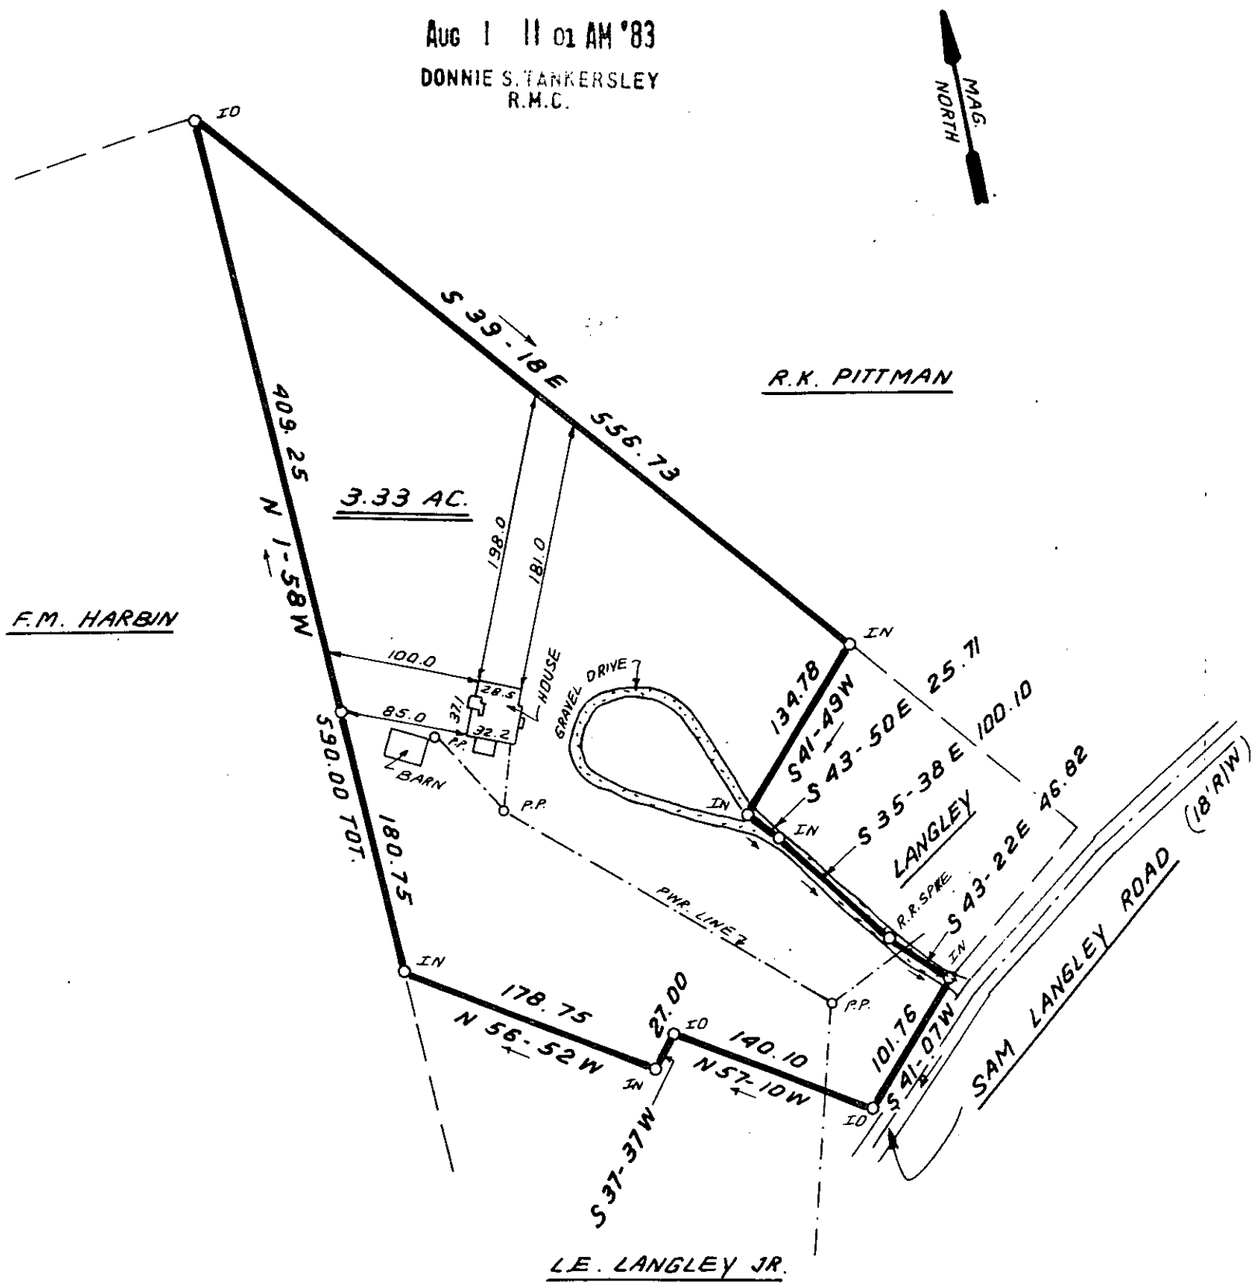

This is to certify that on August 1, 1983, I surveyed the property shown on this plat, known as a part of Tract 1 on the Plat of the Property of Mrs. Bertha Langley, recorded in the RMC Office of Greenville County in Plat Book B on page 61 and that the property lines, walls and buildings are as shown hereon; that the building located on said lot does not encroach or project on adjacent streets or property and that no adjacent walls or buildings encroach or project on said premises, and that no utility lines cross this property except as shown hereon. This property is not located in a designated flood hazard area.

James R. Freeland
James R. Freeland PE and RLS 4781

9X-6

3658

SOUTH CAROLINA REGISTERED LAND SURVEYOR NO. 4781 JAMES RALPH FREELAND

SEAL

STATE OF SOUTH CAROLINA
GREENVILLE COUNTY

PROPERTY OF
ROBERT L. LANGLEY

FREELAND & ASSOCIATES
Engineers • Land Surveyors
GREENVILLE, S.C.

SURVEY	D.C.H.
DRAWN	B.R.
CHECK	M.C.
SCALE	1" = 100'
DATE	AUG. 1. 83
DWG. NO.	9486

5.00 3 51351A01