

**NOTES**

0.9 THERE IS A UTILITY AND DRAINAGE EASEMENT ALONG EACH SIDE OF ALL SIDE PROPERTY LINES, AND A EASEMENT ALONG EACH SIDE OF REAR PROPERTY LINES.


**REVISIONS AND RECERTIFICATIONS**

NO.	BY	DATE	DESCRIPTION	JOB NO. REFERENCE	APP.
1	WNS	26 AUG 83	TITLE CHG., RECERT.	83083	WNS
2					
3					
4					


**REFERENCES**

BB	DB	PB
93-6-4	1095-117	C-238
93-6-3	1056-17	C-238
93-6-5	W-970-19	C-238
	785-553	

**LOCATION MAP**

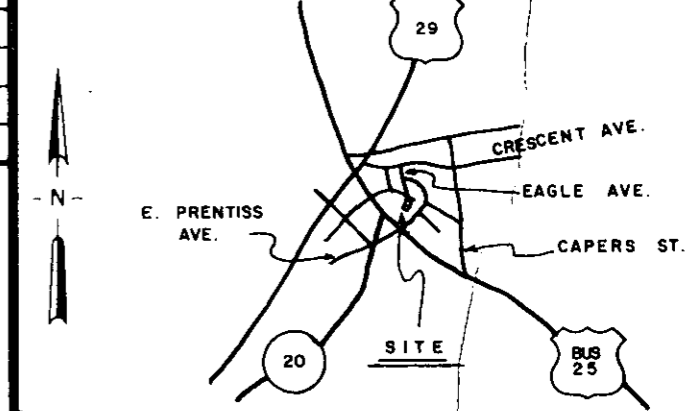

GREENVILLE, S.C.  
 FILED  
 AUG 29 3 06 PM '83  
 DONNIE S. STAMMERSLEY  
 R.M.C.

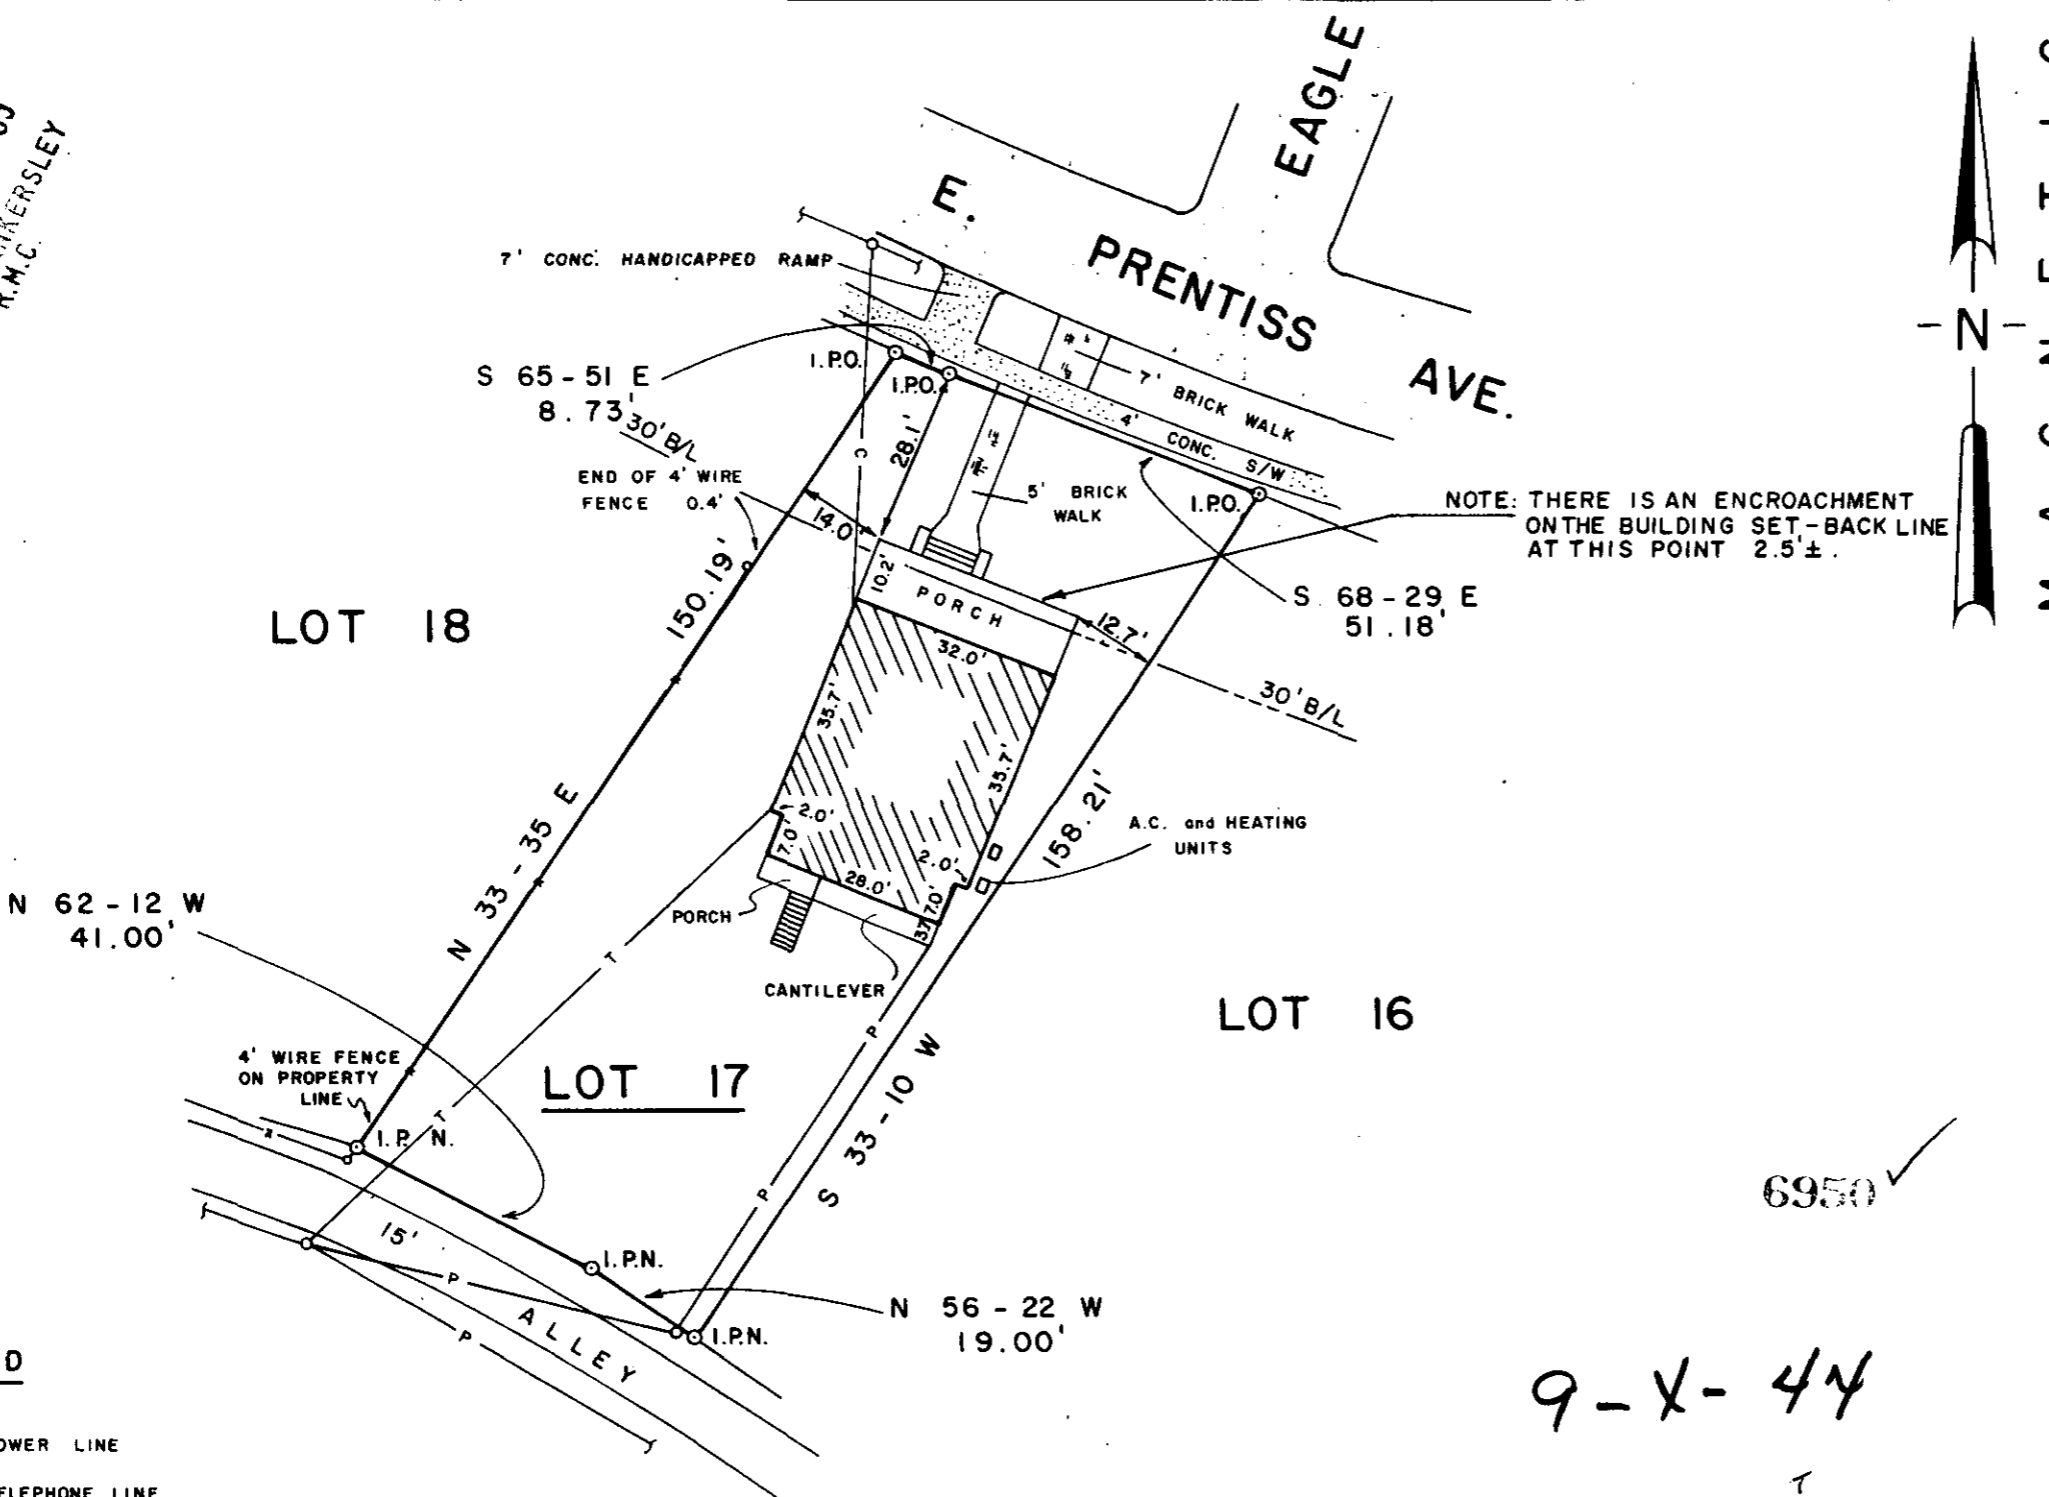

MAGNETIC

**CERTIFICATION**

THIS IS TO CERTIFY TO A.W. THOMAS III THAT AN ACTUAL FIELD SURVEY WAS PERFORMED ON THIS PROPERTY UNDER MY SUPERVISION AND I DECLARE THAT:

(1) THE FIELD SURVEY AND THIS PLAT REPRESENT A DEPENDENT RESURVEY OF THE SUBJECT PROPERTY AND THAT THE INFORMATION SHOWN HEREON IS CORRECT TO THE BEST OF MY PROFESSIONAL KNOWLEDGE AND BELIEF.

(2) ALL RIGHTS OF WAY, EASEMENTS AND ENCROACHMENTS, OBVIOUS AND APPARENT FROM FIELD OBSERVATION OF THE SUBJECT PROPERTY AT THE TIME OF THE SURVEY ARE AS SHOWN.

(3) THE AREA OF THE SUBJECT PROPERTY WAS CALCULATED BY COORDINATES AND THAT THIS IS A CLASS 2 SURVEY.

*William V. Stambaugh*  
 SIGNATURE OF REGISTERED LAND SURVEYOR DATE 8/29/83 S.C. REG. NO. 7281

THIS IS TO CERTIFY TO \_\_\_\_\_ THAT THIS DRAWING IS A COMPOSITE PLAT AND DOES NOT CONSTITUTE AN ACTUAL FIELD SURVEY, AND THAT ANY USE OF THIS DRAWING FOR ANY PURPOSE OTHER THAN GENERAL REFERENCE IS DONE SO WITH THE UNDERSTANDING THAT ARBOR ENGINEERING INC. ASSUMES NO RESPONSIBILITY OR LIABILITY FOR ITS ACCURACY OR CORRECTNESS.

SIGNATURE OF REGISTERED LAND SURVEYOR \_\_\_\_\_ DATE \_\_\_\_\_ S.C. REG. NO. \_\_\_\_\_

THE DEPARTMENT OF HOUSING AND URBAN DEVELOPMENT FLOOD WAY DATA FOR GREENVILLE COUNTY SHOWS THIS PROPERTY  TO BE IN A FLOOD PLAIN AREA  NOT TO BE IN A FLOOD PLAIN AREA  LOCATION CANNOT BE DETERMINED.

**PROPERTY SURVEY FOR  
 A.W. THOMAS III  
 AND KAY T. THOMAS**  
 LOT 17, BLOCK D  
 CAGLE PARK COMPANY

GREENVILLE SOUTH CAROLINA

SCALE 30 20 10 0 30 60  
 1" = 30'

RESEARCH TAG	DRAWN DPB	CHECK WNS	DATE 11 APR. 83
FILE	FIELD WORK BY DPB/WCM	JOB NO. 83083	

**ARBOR ENGINEERING**  
 P.O. BOX 263, GREENVILLE, S.C.  
 LANDSCAPE ARCHITECTS ENGINEERS LAND SURVEYORS

**LEGEND**

- P — POWER LINE
- T — TELEPHONE LINE
- C — CABLE LINE

6950 ✓  
 9-X-44  
 AUG 29 1983