

FILED

MICROFILMED


GREENVILLE CO. S.C.

AUG 9 9 03 AM '83

DONNIE S. TANKERSLEY
R.M.C.

NOTE: Improvements
on this lot are
not in a flood
hazard area.

NS 2-1SE
B.D. C.
100' 0"

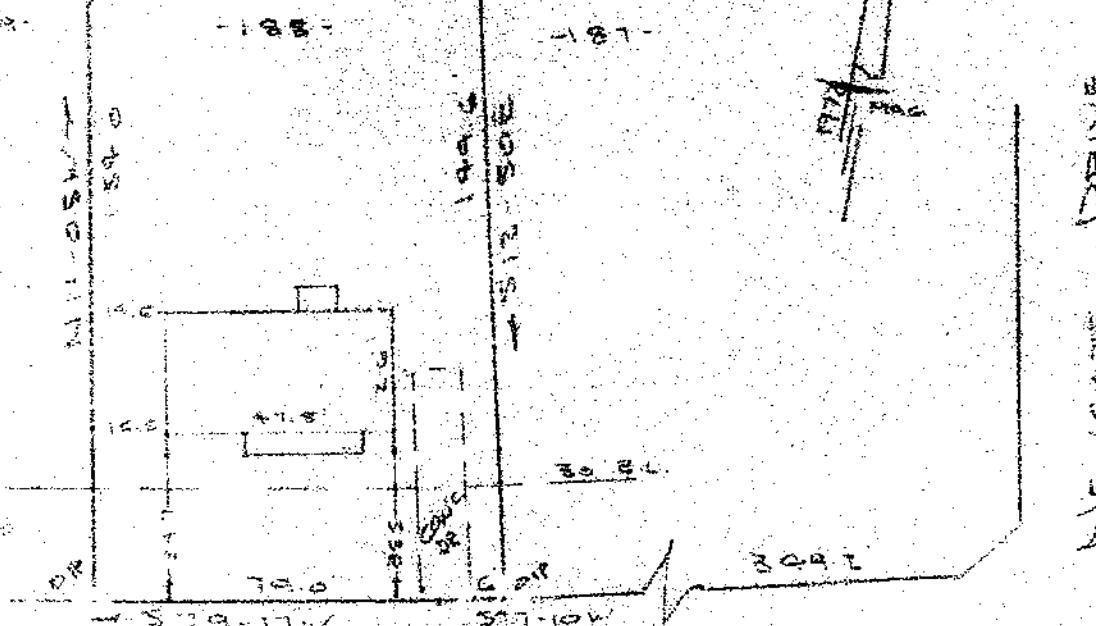

CLOVERDALE LANE

NEAR GREENVILLE, S.C.

AUG 9 1983

PROPERTY OF
ROBERT F. HAUGHWOUT & PATRICIA A. HAUGHWOUT
NEAR GREENVILLE, S.C.

RE SURG - 1983 40'

This is to certify that on the 9th day of Aug., 1983 I surveyed the property shown on this plat, being known as lot 188 on plat of Section No. 2 BILLINGHAM and recorded in the RMC Office Greenville County, S. C., in Plat Book "4 - N" at Page 79; and that the property lines, walls and buildings are as shown hereon, and that the walls and buildings located on said lot do not encroach or project on adjacent street or property, and that no adjacent walls or buildings encroach or project on said premises, and no power lines cross this property except as shown hereon.

R. E. Bruce
R. E. Bruce, R.S.C. #1992

4665
9Y-55

CAROLINA SURVEYING CO.
112 Main St.
Greenville, S.C.

