


This is to certify that on August 9, 1983, I surveyed the property shown on this plat, known as Lot 67 on the plat of Devenger Place (Sec. 6), recorded in the RIC Office of Greenville County in Plat Book 5P on page 2 and that the property lines, walls and buildings are as shown hereon; that the building located on said lot does not encroach or project on adjacent streets or property and that no adjacent walls or buildings encroach or project on said premises, and that no utility lines cross this property except as shown hereon. This property is not located in a designated flood hazard area.


James R. Freeland
James R. Freeland RLS & PE 4781

Note: 5' drainage easement along all rear & side lot lines.

SCTO
--
1 AU-9
80
1454

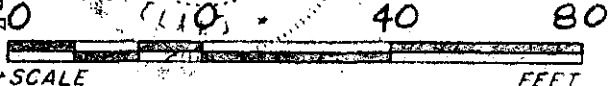

4711 ✓ 9-Y-60

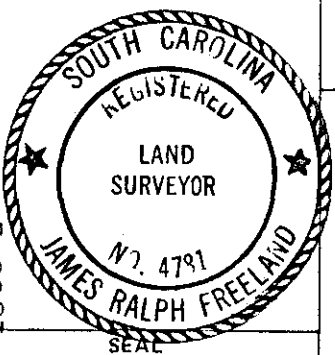

STATE OF SOUTH CAROLINA
GREENVILLE COUNTY
DEVENGER PLACE
SEC. 6 - LOT 67
PROPERTY OF
AARON DAVIS
SUSAN DAVIS

FREELAND & ASSOCIATES Engineers • Land Surveyors	
GREENVILLE, S.C.	
SURVEY	JEC
DRAWN	MC
CHECK	M.C.
SCALE	1" = 40'
DATE	8-9-83
DWG. NO.	83-9525