


3.0001

377 2 AU 9 83

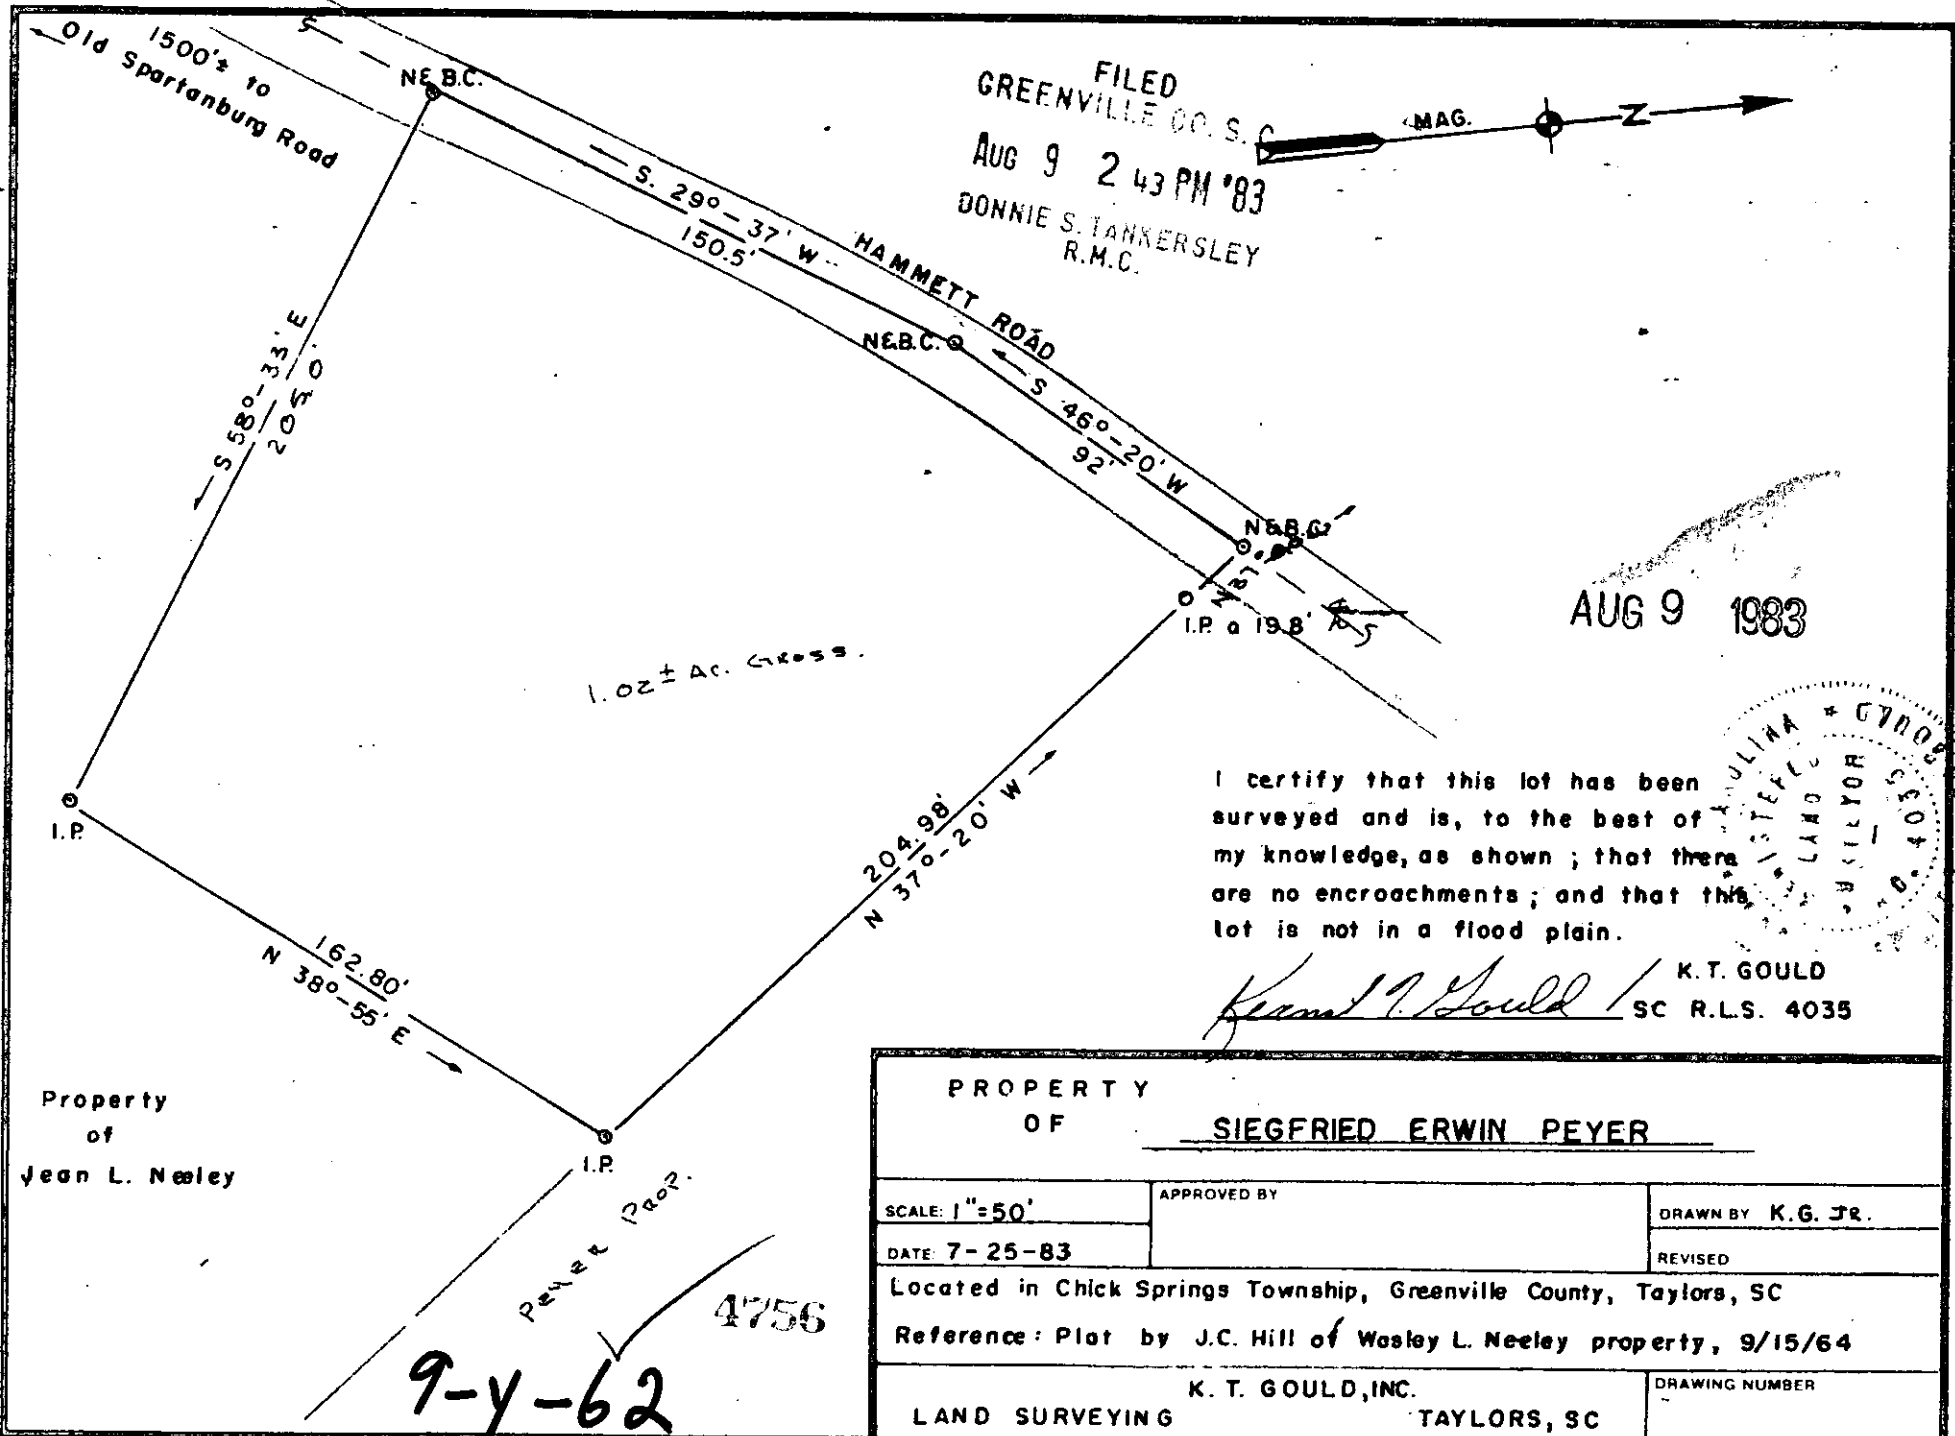

I certify that this lot has been surveyed and is, to the best of my knowledge, as shown; that there are no encroachments; and that this lot is not in a flood plain.

*Kenneth T. Gould* K. T. GOULD  
SC R.L.S. 4035

PROPERTY OF <u>SIEGFRIED ERWIN PEYER</u>		
SCALE: 1"=50'	APPROVED BY	DRAWN BY K.G. JR.
DATE 7-25-83		REVISED
Located in Chick Springs Township, Greenville County, Taylors, SC		
Reference: Plot by J.C. Hill of Wesley L. Neeley property, 9/15/64		
LAND SURVEYING	K. T. GOULD, INC. TAYLORS, SC	DRAWING NUMBER

MICROFILMED