MICROFILMED

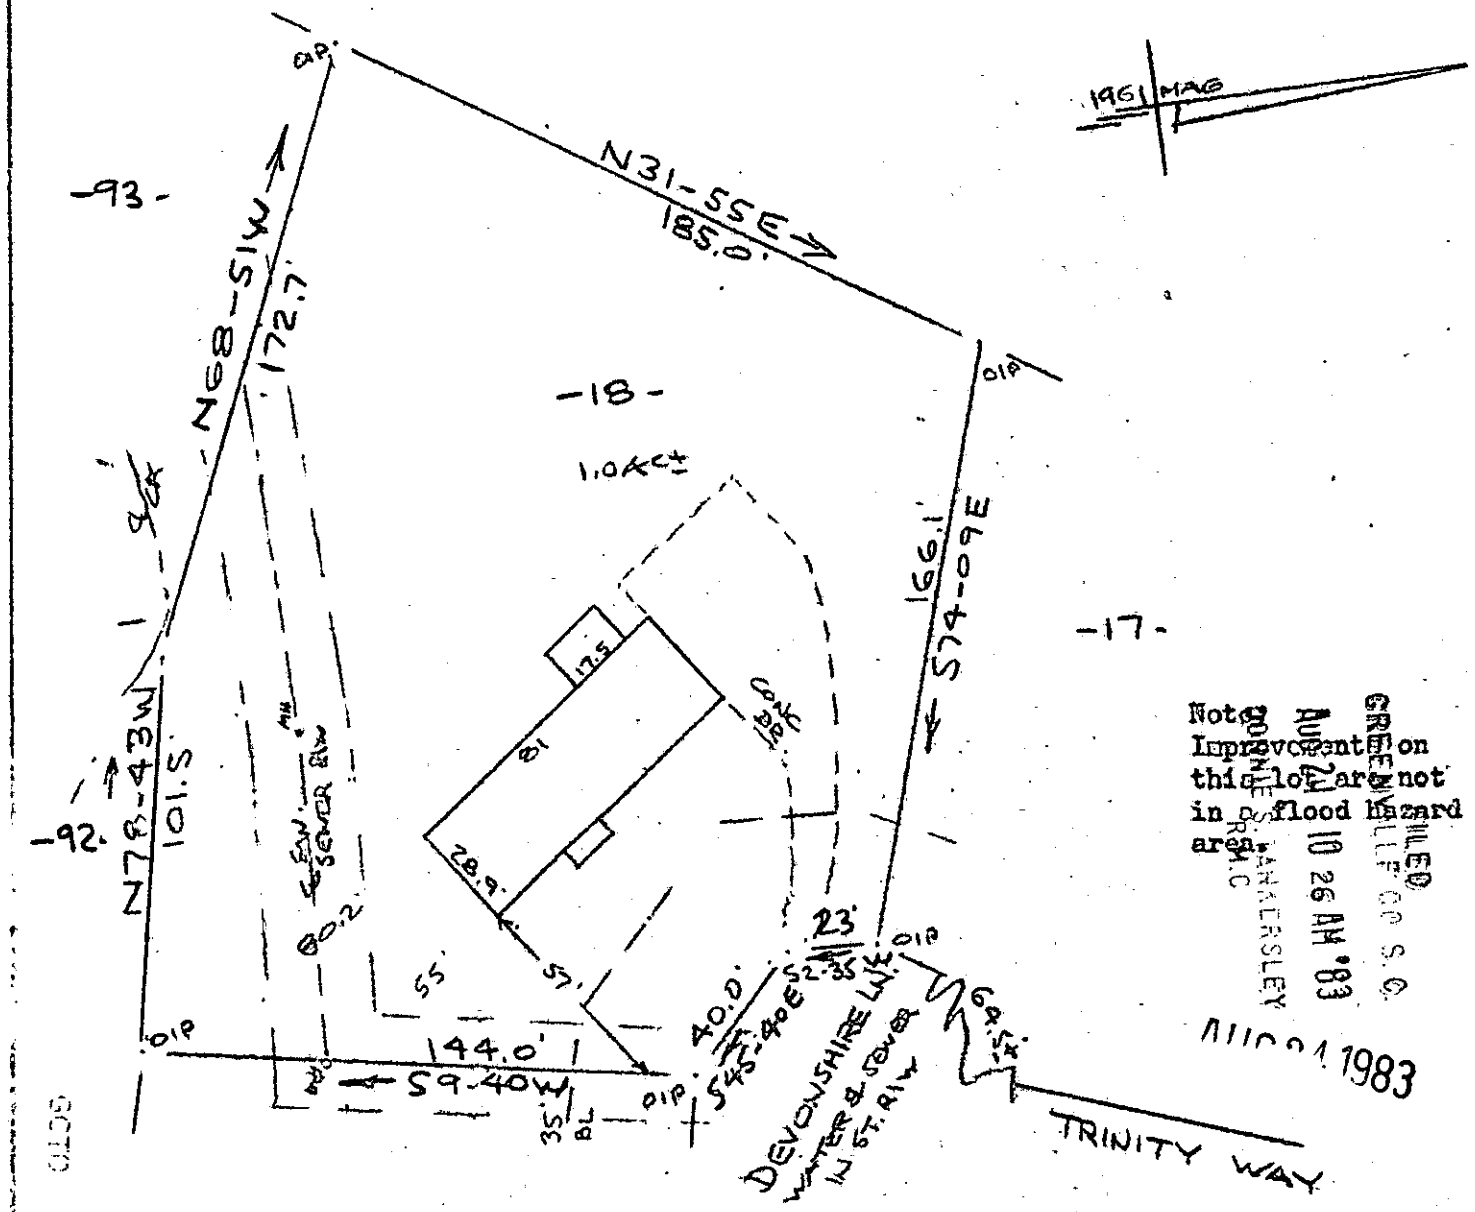

Note: Improvement on this lot are not in a flood hazard area.

MICROFILMED
GREENVILLE CO. S.C.
AUG 26 10 AM '83
DONNIE S. TANKERSLEY
R.M.C.

AUG 31 1983

PROPERTY OF
RALPH B. McRAE & FREIDA B. McRAE
NEAR GREENVILLE, S.C.
50 18AUG 0 1983 50'

9-2-8

This is to certify that on the 18th day of August, 1983, I surveyed the property shown on this plat, being known as lot 18 on plat of NORTHWOOD HILLS and recorded in the RMC Office Greenville County, S. C., in Plat Book " QQ " at Page 156; and also known as PROPERTY OF RALPH B. McRAE & FREIDA B. McRAE recorded in Plat Book at Page ; and that the property lines, walls and buildings are as shown hereon, and that the walls and buildings located on said lot do not encroach or project on adjacent street or property, and that no adjacent walls or buildings encroach or project on said premises, and no power lines cross this property except as shown hereon.

6455

R. B. Bruce, PLS

CAROLINA SURVEYING CO.
112 Manly St.
Greenville, S. C.

SCTD 1 AU24 83 1066
3.00CI