
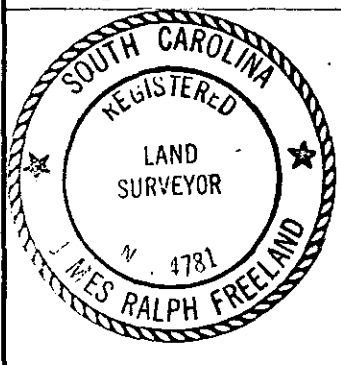


This is to certify that on August 22, 1983, I surveyed the property shown on this plat, known as Lot 30 on Plat of Sunset Hills, (plat 2), recorded in the REC Office of Greenville County in Plat Book P on page 19, and that the property lines, walls and buildings are as shown hereon; that the building located on said lot does not encroach or project on adjacent streets or property, and that no adjacent walls or buildings encroach or project on said premises, and that no utility lines cross this property except as shown hereon. This property is not located in a designated flood hazard area.

James R. Freeland
James R. Freeland RLS & PE 4781

FILED
GREENVILLE CO. S. C.
AUG 25 11 24 AM '83
AUG 25 1983
DONNIE S. TANKERSLEY
R.M.C.

9-2

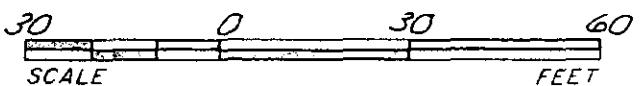

STATE OF SOUTH CAROLINA
GREENVILLE COUNTY

SUNSET HILLS 6587
PLAT 2 ; LOT 30
PROPERTY OF
DANIEL G. LANGLEY
ANGELA P. LANGLEY

FREELAND & ASSOCIATES
Engineers • Land Surveyors

GREENVILLE, S.C.

SURVEY	H.B.
DRAWN	K.E.G.
CHECK	M.C.
SCALE	1"=30'
DATE	8-22-83
DWG. NO.	9615 3.00CI