


This is to certify that on September 9, 1983, I surveyed the property shown on this plat, known as Lot 117 on the plat of Brookfield East, sec. If recorded in the RMC Office of Greenville County in Plat Book 7C on page 21 and that the property lines, walls and buildings are as shown hereon; that the building located on said lot does not encroach or project on adjacent streets or property and that no adjacent walls or buildings encroach or project on said premises, and that no utility lines cross this property except as shown hereon. This property is not located in a designated flood hazard area.

James R. Freeland RLS & PE 4781

drainage and utility easement along side lot lines and a 10' easement along rear lot lines.

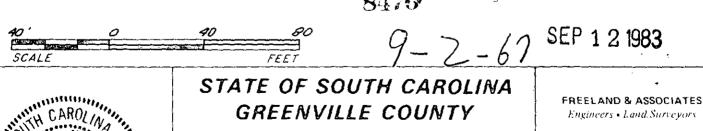


00

PRINT MACHINE, INE. 10 BIG 18 6 1

BROOKFIELD EAST

SEC. I ; LOT 117

PROPERTY OF

MATTHEW B. BOLTON

SUSAN R. BOLTON

SURVEY 4.8.

DRAWN K.E.G

CHECK MC.

SCALE /"= 40"

DATE 9-9-83

DWG. NO. 9692

GREENVILLE, S.C.