

DUKE TRANSMISSION

CORDELL SUB-DIV -13- -14- -15- -16-

N 2-50 E

74.4' 0.10'

N 8-50 E

36 178.3'

N 60-10 W

- 0.51 AC -

CONC DRIVE

PRECISION BORING & TUNNEL INC.

S 45-23 W

248.9'

49.5'

45'

154.0'

S 54-35 E


BENT BAIDE ROAD

CURTIS ROAD WATER & SEWER IN ST. R/W.

Note: Improvements on this lot are not in a flood hazard area.

FILED GREENVILLE S.C. SEP 19 3 43 PM '83 DONNIE S. ADKERSLEY R.M.C.

PROPERTY OF M. E. DURHAM II NEAR GREENVILLE, S.C. SCALE 1" = 40 16 SEPT 1983

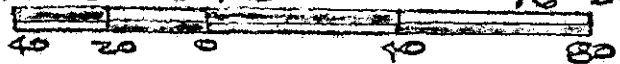

This is to certify that on the 16th day of September, 1983, I surveyed the property shown on this plat, being known as PROPERTY OF M. E. DURHAM II and recorded in the REC Office Greenville County, S. C., in Plat Book at Page ; and that the property lines, walls and buildings are as shown hereon, and that the walls and buildings located on said lot do not encroach or project on adjacent street or property, and that no adjacent walls or buildings encroach or project on said premises, and no power lines cross this property except as shown hereon.

92-89

9289 ✓

R. B. Bruce

CAROLINA SURVEYING CO. 112 Manly St. Greenville, S. C.

