MICROFILMED

FILED
GREENVILLE CO. S.C.
SEP 21 3 26 PM '83
DONNIE S. TANKERSLEY
R.M.C.

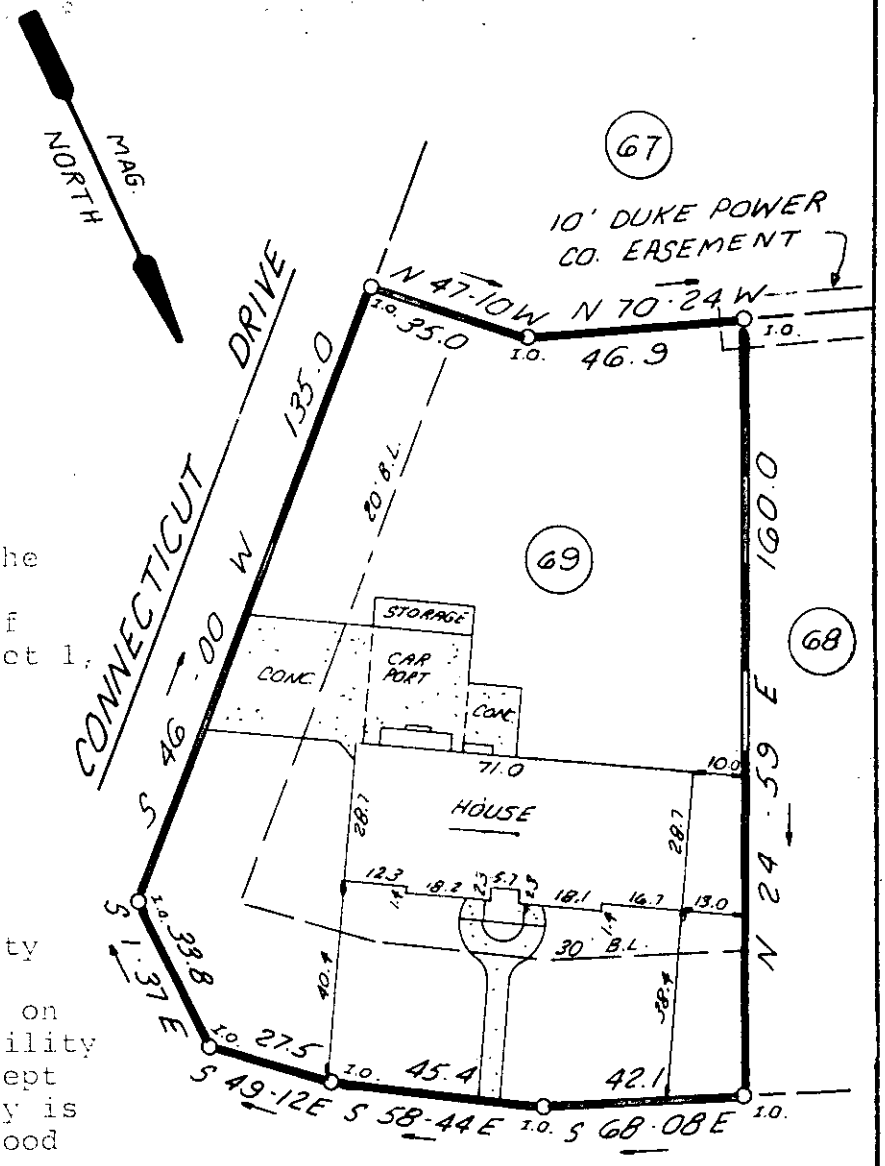

This is to certify that on August 29, 1983, I surveyed the property shown on this plat, known as Lot 69 on the plat of Merrifield Park, Sec. II, Sheet 1, recorded in the RMC Office of Greenville County in Plat Book WWW on page 50 and 51 and that the property lines, walls and buildings are as shown hereon; that the building located on said lot does not encroach or project on adjacent streets or property and that no adjacent walls or buildings encroach or project on said premsies, and that no utility lines cross this property except as shown hereon. This property is not located in a designaed flood hazard area.

James R. Freeland PE and RLS 4781


40 0 40 80
SCALE FEET

9-2-100 9578

SOUTH CAROLINA REGISTERED LAND SURVEYOR 4781 JAMES R. FREELAND

SEAL

STATE OF SOUTH CAROLINA
GREENVILLE COUNTY

MERRIFIELD PARK
SEC. II ; SHEET 1 ; LOT 69
PROPERTY OF
WILLIAM F. FREEMAN III &
CATHERINE O. FREEMAN

FREELAND & ASSOCIATES
Engineers • Land Surveyors
GREENVILLE, S.C.

SURVEY	H.B
DRAWN	K.E.G.
CHECK	M.C.
SCALE	1" = 40'
DATE	8-29-83
DWG. NO.	9645

THE PRINT MACHINE, INC. N30331