MICROFILMED

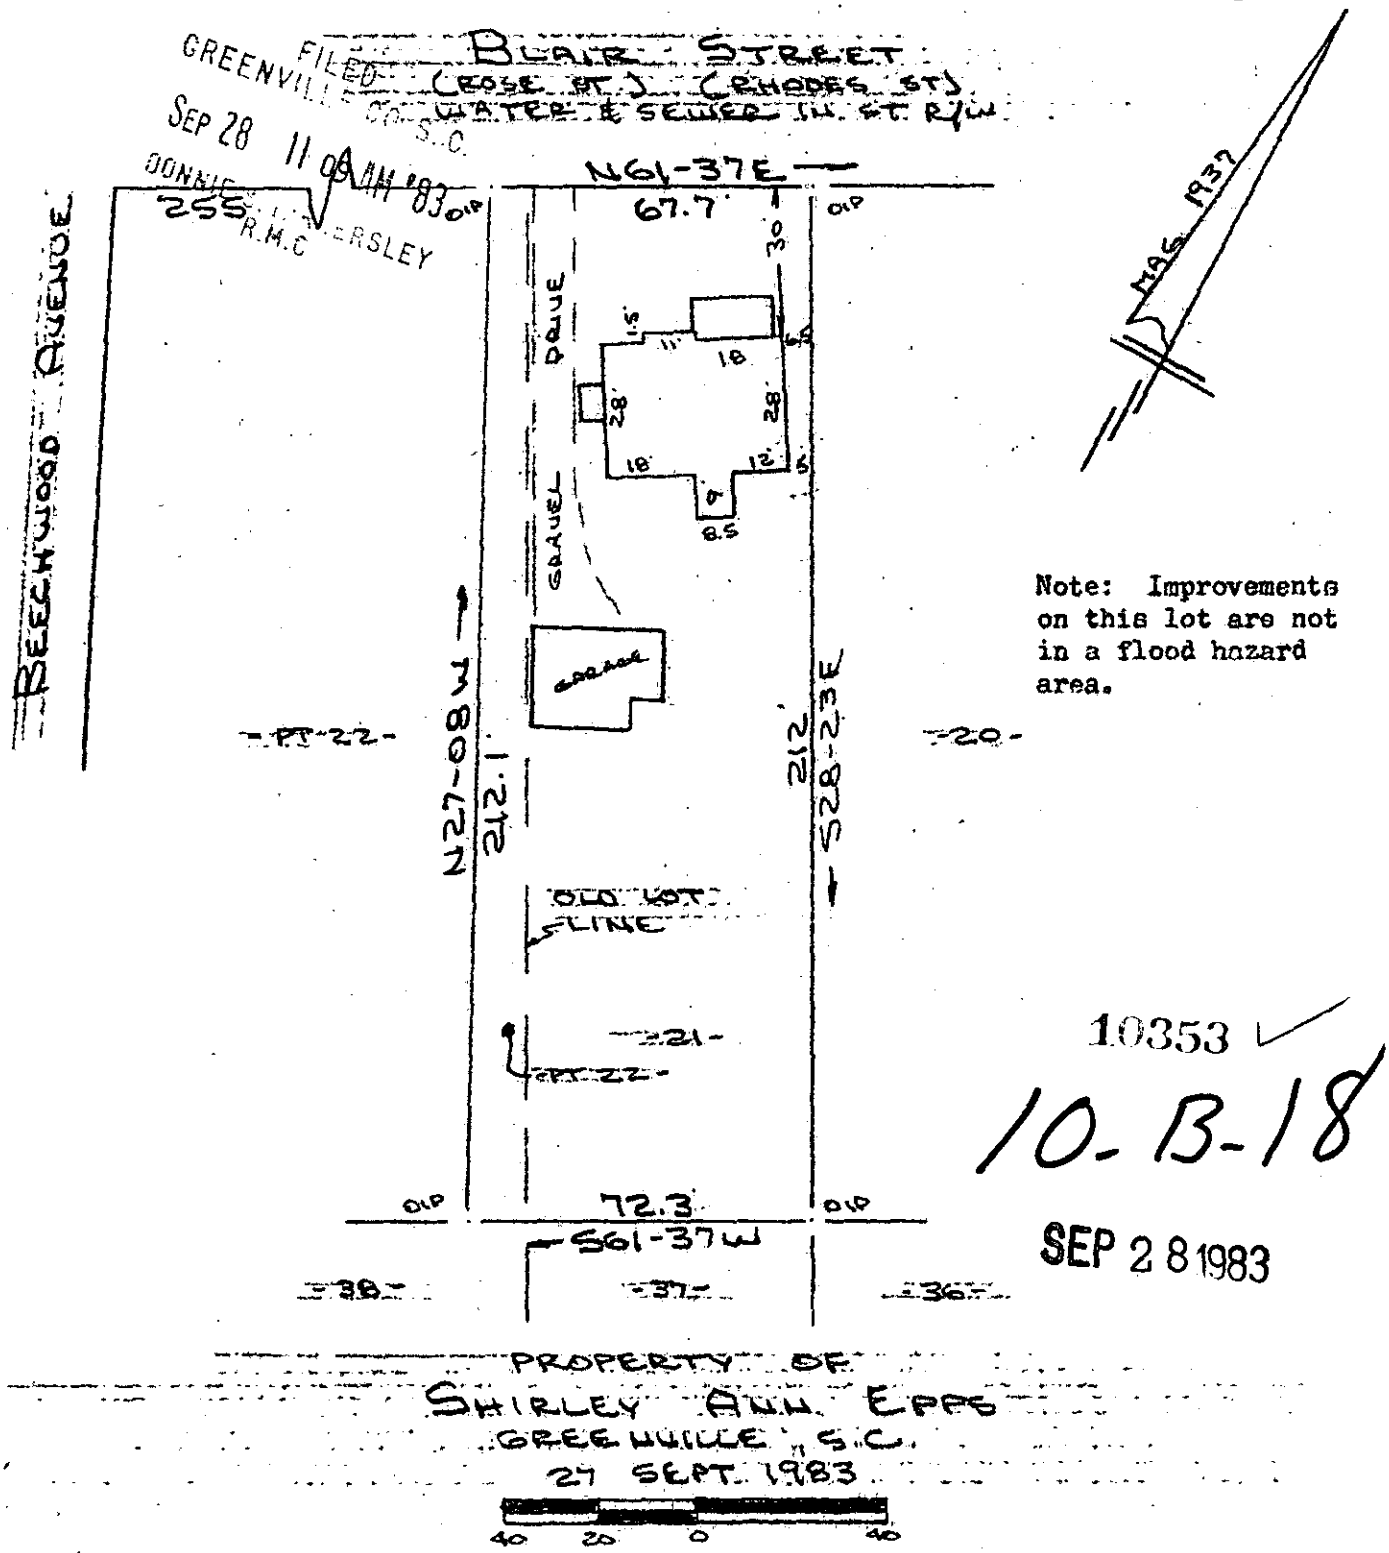

Note: Improvements on this lot are not in a flood hazard area.

10353

10-B-18

SEP 28 1983

This is to certify that on the 27th day of September, 1983, I surveyed the property shown on this plat, being known as lot 21 and part of lot 22 on plat of PROPERTY OF MRS. CORINNE BATES recorded in the RMC Office Greenville County, S. C., in Plat Book " I " at Page 126 also known as PROPERTY OF SHIRLEY ANN EPPS and recorded in Plat Book at Pg. ; and that the property lines, walls and buildings are as shown hereon, and that the walls and buildings located on said lot do not encroach or project on adjacent street or property, and that no adjacent walls or buildings encroach or project on said premises, and no power lines cross this property except as shown hereon.

CAROLINA SURVEYING CO.
112 Manly St.
Greenville, S. C.

R. B. Bruce
R. B. Bruce, RLS #1952

1 SEP 28 83 1407

3.00