


MICROFILMED

FILED
GREENVILLE CO. S. C.

SEP 30 4 11 PM '83
DONNIE S. TANKERSLEY
R.M.C.



This is to certify that on September 26, 1983, I surveyed the property shown on this plat, known as Lot 7 on Plat of J.R. West Property, recorded in the RMC Office of Greenville County in Plat Book D on Page 268, and that the property lines, walls and buildings are as shown hereon; that the building located on said lot does not encroach or project on adjacent streets or property, and that no adjacent walls or buildings encroach or project on said premises, and that no utility lines cross this property except as shown hereon. This property is not located in a designated flood hazard area.

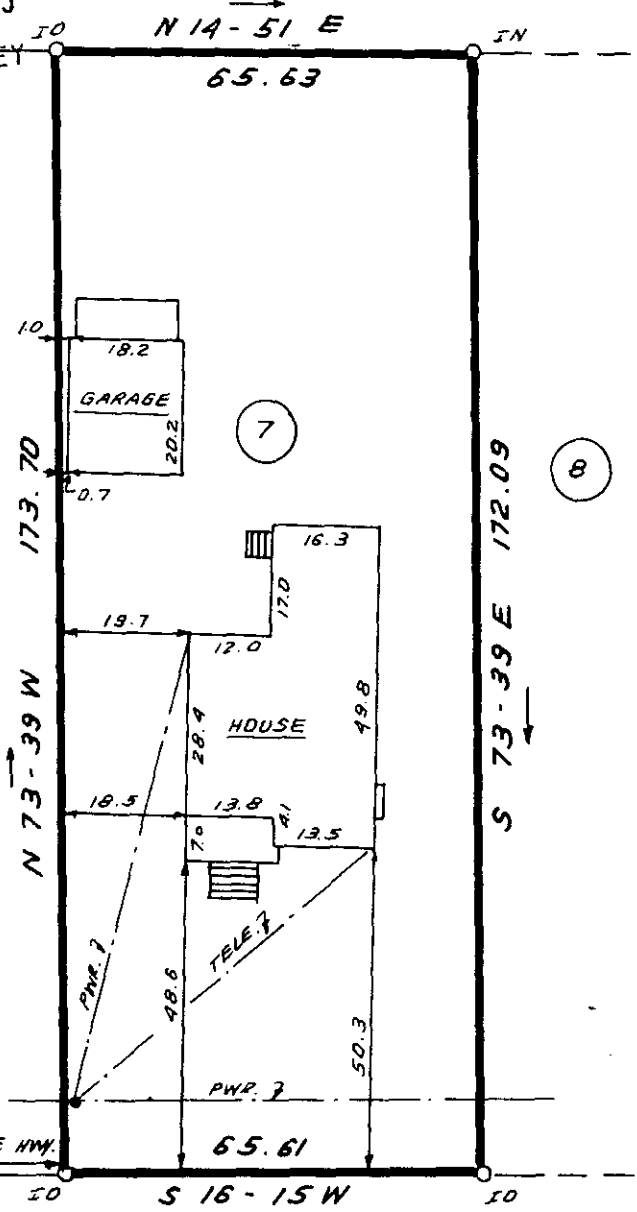

James R. Freeland
James R. Freeland RLS & PE 4781

345' LTD EASLEY-GREENVILLE HWY.

WEST AVENUE



10-B-33

10797

STATE OF SOUTH CAROLINA
GREENVILLE COUNTY

FREELAND & ASSOCIATES
Engineers • Land Surveyors

GREENVILLE S.C.


J.R. WEST SUBDIVISION

LOT 7

PROPERTY OF

ANN T. JOHNSON

SURVEY	H.B.
DRAWN	B.R.
CHECK	M.C.
SCALE	1" = 30'
DATE	SEPT. 26. 83
DWG. NO.	9763

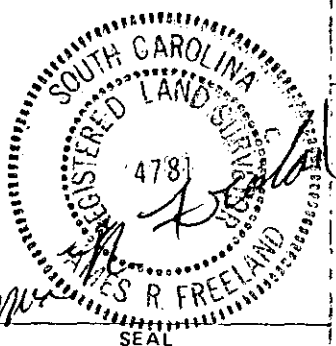

THE PRINT MACHINE, INC. N00331

6620 - 2 SE 30 83

662

3.00CI