


MICROFILMED

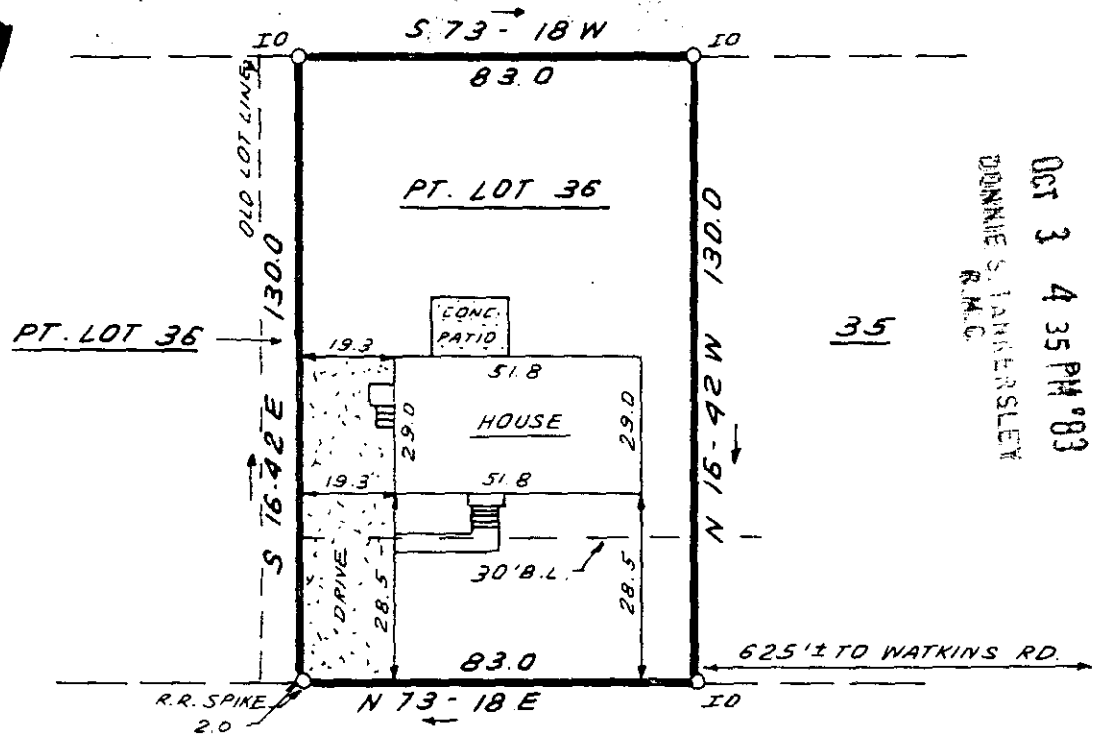

FILED
 GREENVILLE CO. S.C.
 OCT 3 4 35 PM '83
 DONNIE S. JAMES/RSLEY
 R.M.C.

BEREA FOREST CIRCLE


This is to certify that on September 29, 1983, I surveyed the property shown on this plat, known as Sec 2, Pt. Lot 36 on plat of Berea Forest, recorded in the RMC Office of Greenville County in Plat Book 4N on page 16, and that the property lines, walls and buildings are as shown hereon; that the building located on said lot does not encroach or project on adjacent streets or property, and that no adjacent walls or buildings encroach or project on said premises, and that no utility lines cross this property except as shown hereon. This property is not located in a designated flood hazard area.

Note. 5' utility and drainage easement each side of all side and rear lot line lines.


James R. Freeland
 James R. Freeland PE & RLS 4781

10982 ✓

OCT 3 1983

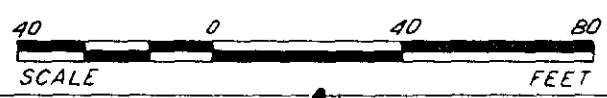

10-B-44

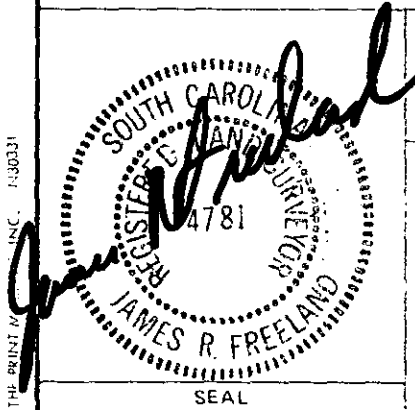

STATE OF SOUTH CAROLINA
 GREENVILLE COUNTY

BEREA FOREST
SEC. 2; PT. LOT 36
PROPERTY OF
HERBERT E. WALLER
CYNTHIA B. WALLER

FREELAND & ASSOCIATES Engineers • Land Surveyors	
GREENVILLE, S.C.	
SURVEY	J.E.C.
DRAWN	B.R.
CHECK	MC
SCALE	1" = 40'
DATE	SEPT. 29. 83
DWG. NO.	9784 3.0000

THE PRINTING CO. INC. 1-800-331

(1814)