


FILED
GREENVILLE CO. S. C.

NB R100 PG 45

MICROFILMED

Oct 27 12 23 PM '83

DONNIE S. TANKERSLEY
R.M.C.

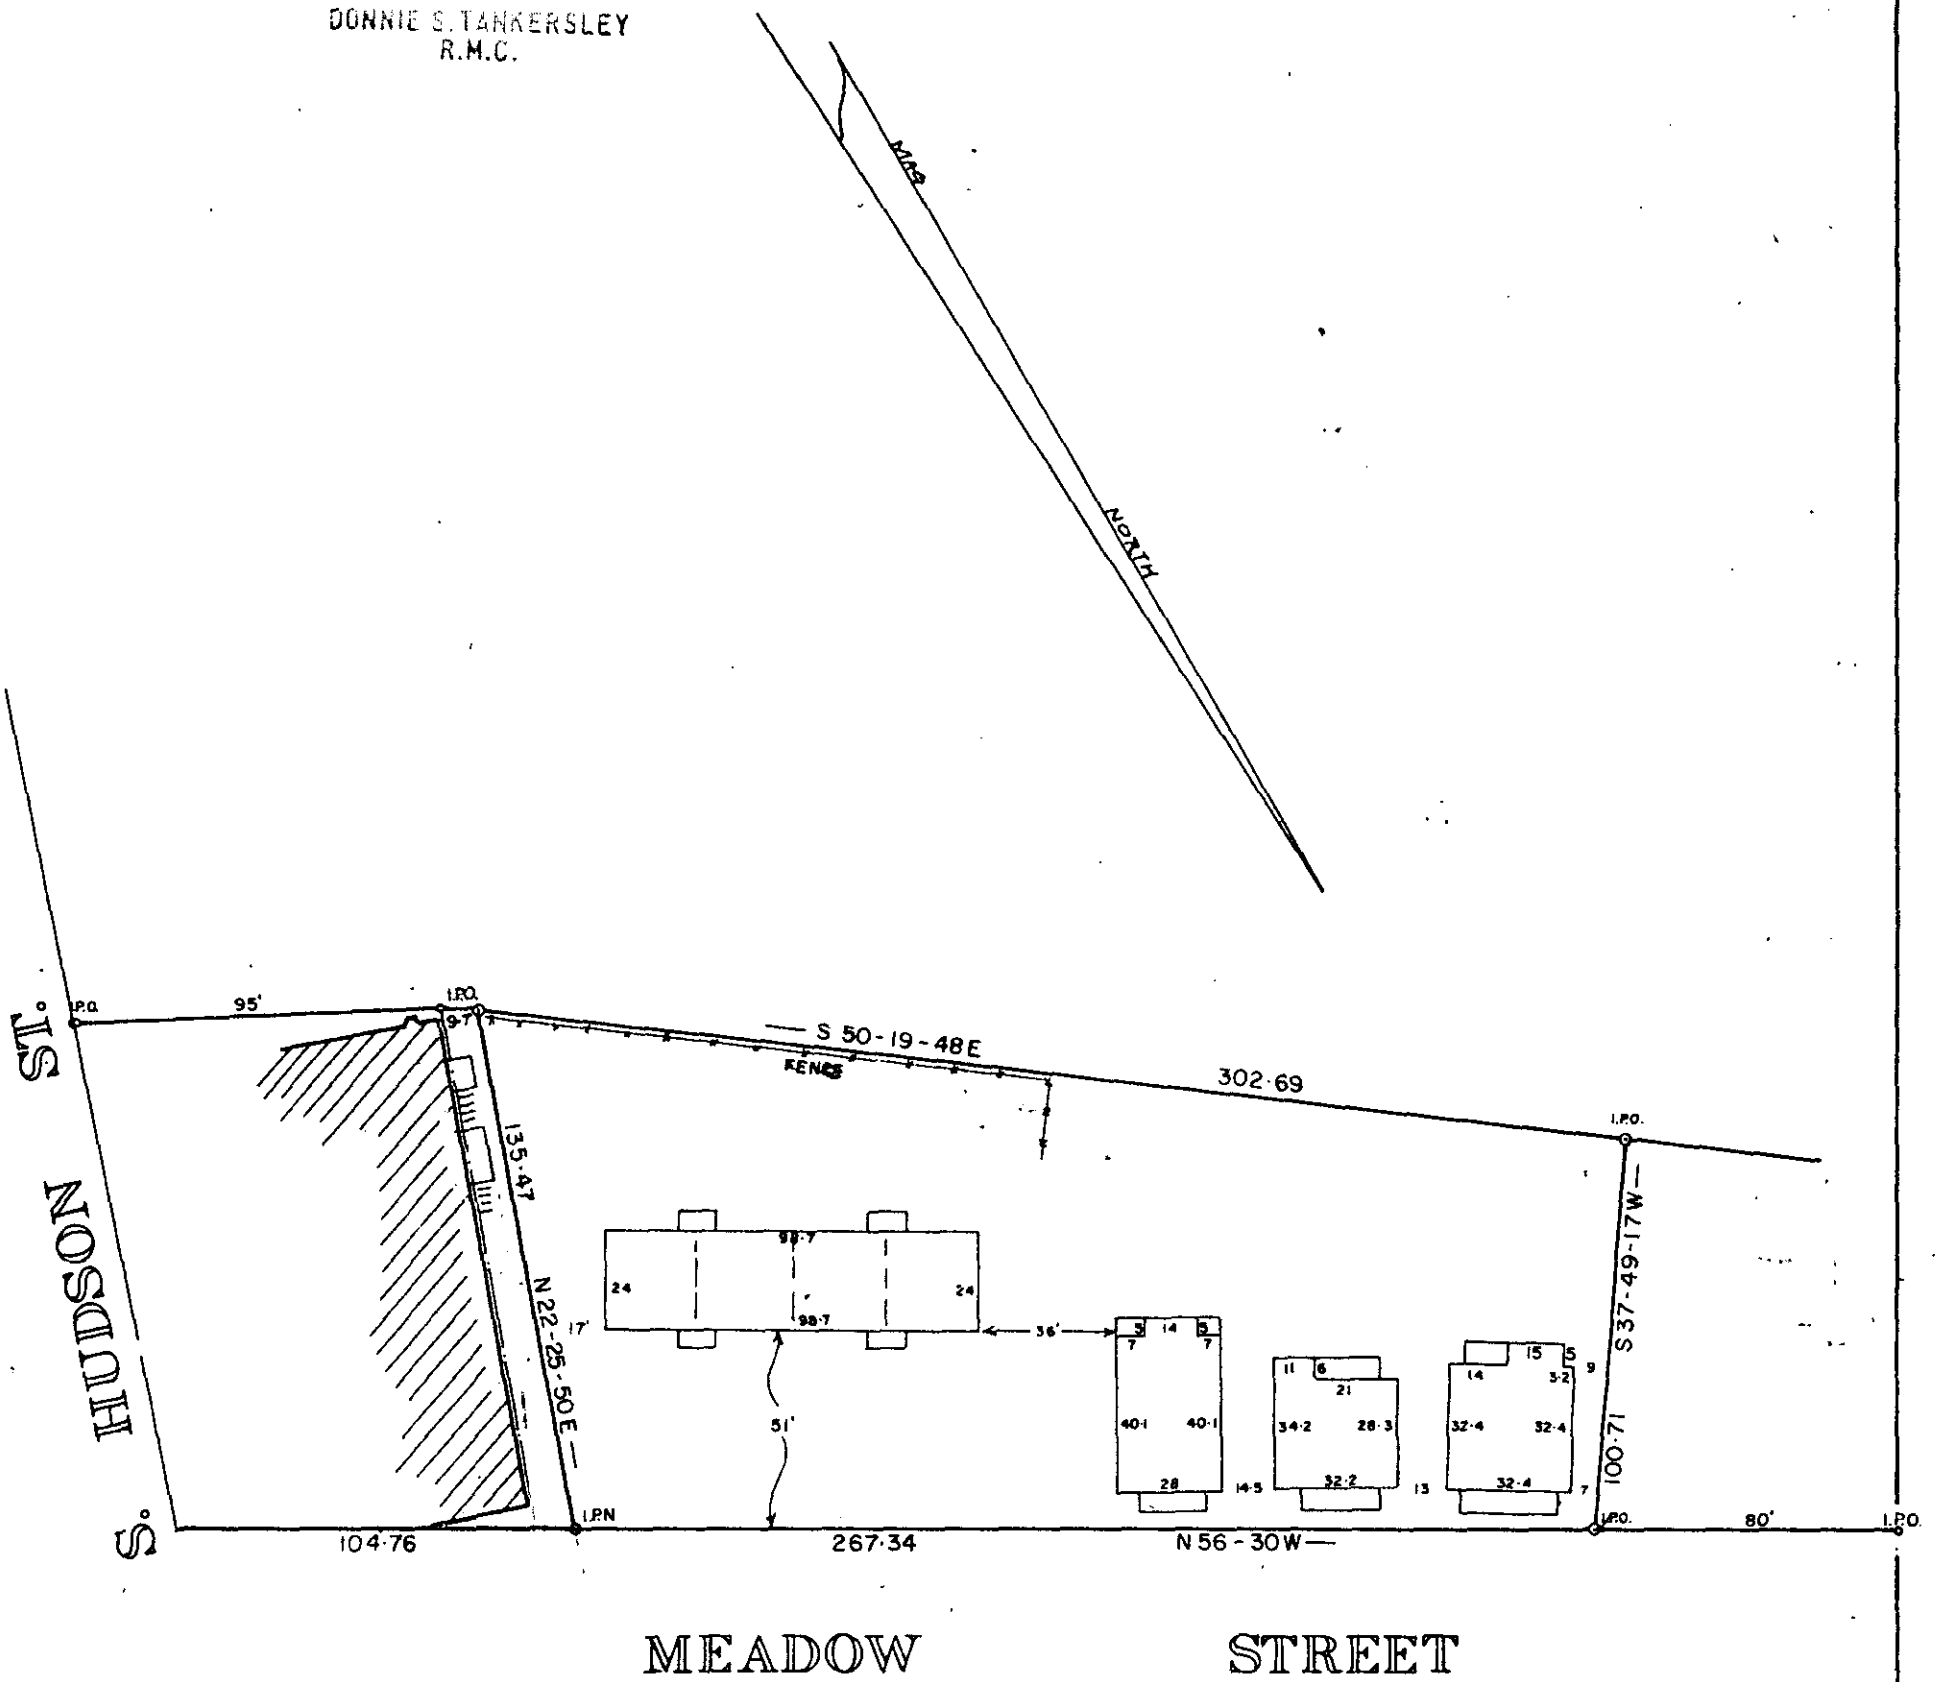


PROPERTY OF
WARD S. STONE SR.


GREENVILLE, S. C.

OCT. - 18 - 1983

SCALE 1" = 50'

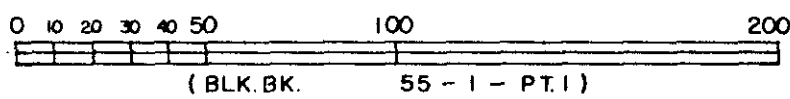

10-C-31

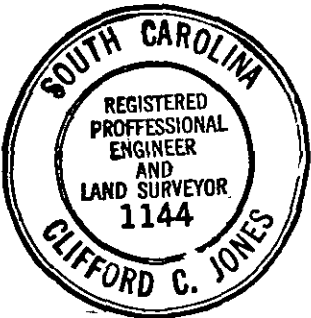

20027-23 1431
5.0001