


Note:
Improvements on this lot are not in a flood hazard area.

CATHEY STREET
(SECOND STREET)
WATER & SEWER IN ST R/W

OPPER'S STREET
(SECOND AVENUE)

FILED
GREENVILLE CO. S.C.
NOV 21 10 43 AM '83
BUNNIE S. LANKERSLEY
R.M.C.

PROPERTY OF
DAVID R. MEEKS
NEAR GREENVILLE, S.C.
10 NOV 1983

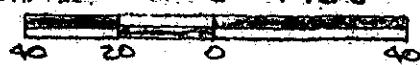

This is to certify that on the 10th day of November, 1983, I surveyed the property shown on this plat, being known as part of lot 1 and part of lot 3 on plat of Block K PARK PLACE and recorded in the RMC Office Greenville County, S. C., in Plat Book " A " at Page 119 and also known as PROPERTY OF DAVID R. MEEKS and recorded in the RMC Office Greenville County, S. C., in Plat Book at Page ; and that the property lines, walls and buildings are as shown hereon, and that the walls and buildings located on said lot do not encroach or project on adjacent street or property, and that no adjacent walls or buildings encroach or project on said premises, and no power lines cross this property except as shown hereon.


Recordable Plat

NOV 21 1983
16407

R. B. Bruce, R.L.S. 1952

10-E-15

CAROLINA SURVEYING CO.
112 Manly St.
Greenville, S. C.

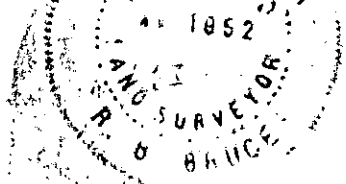

GCTC -----3 NO22 83 043 3.0000