MICROFILMED

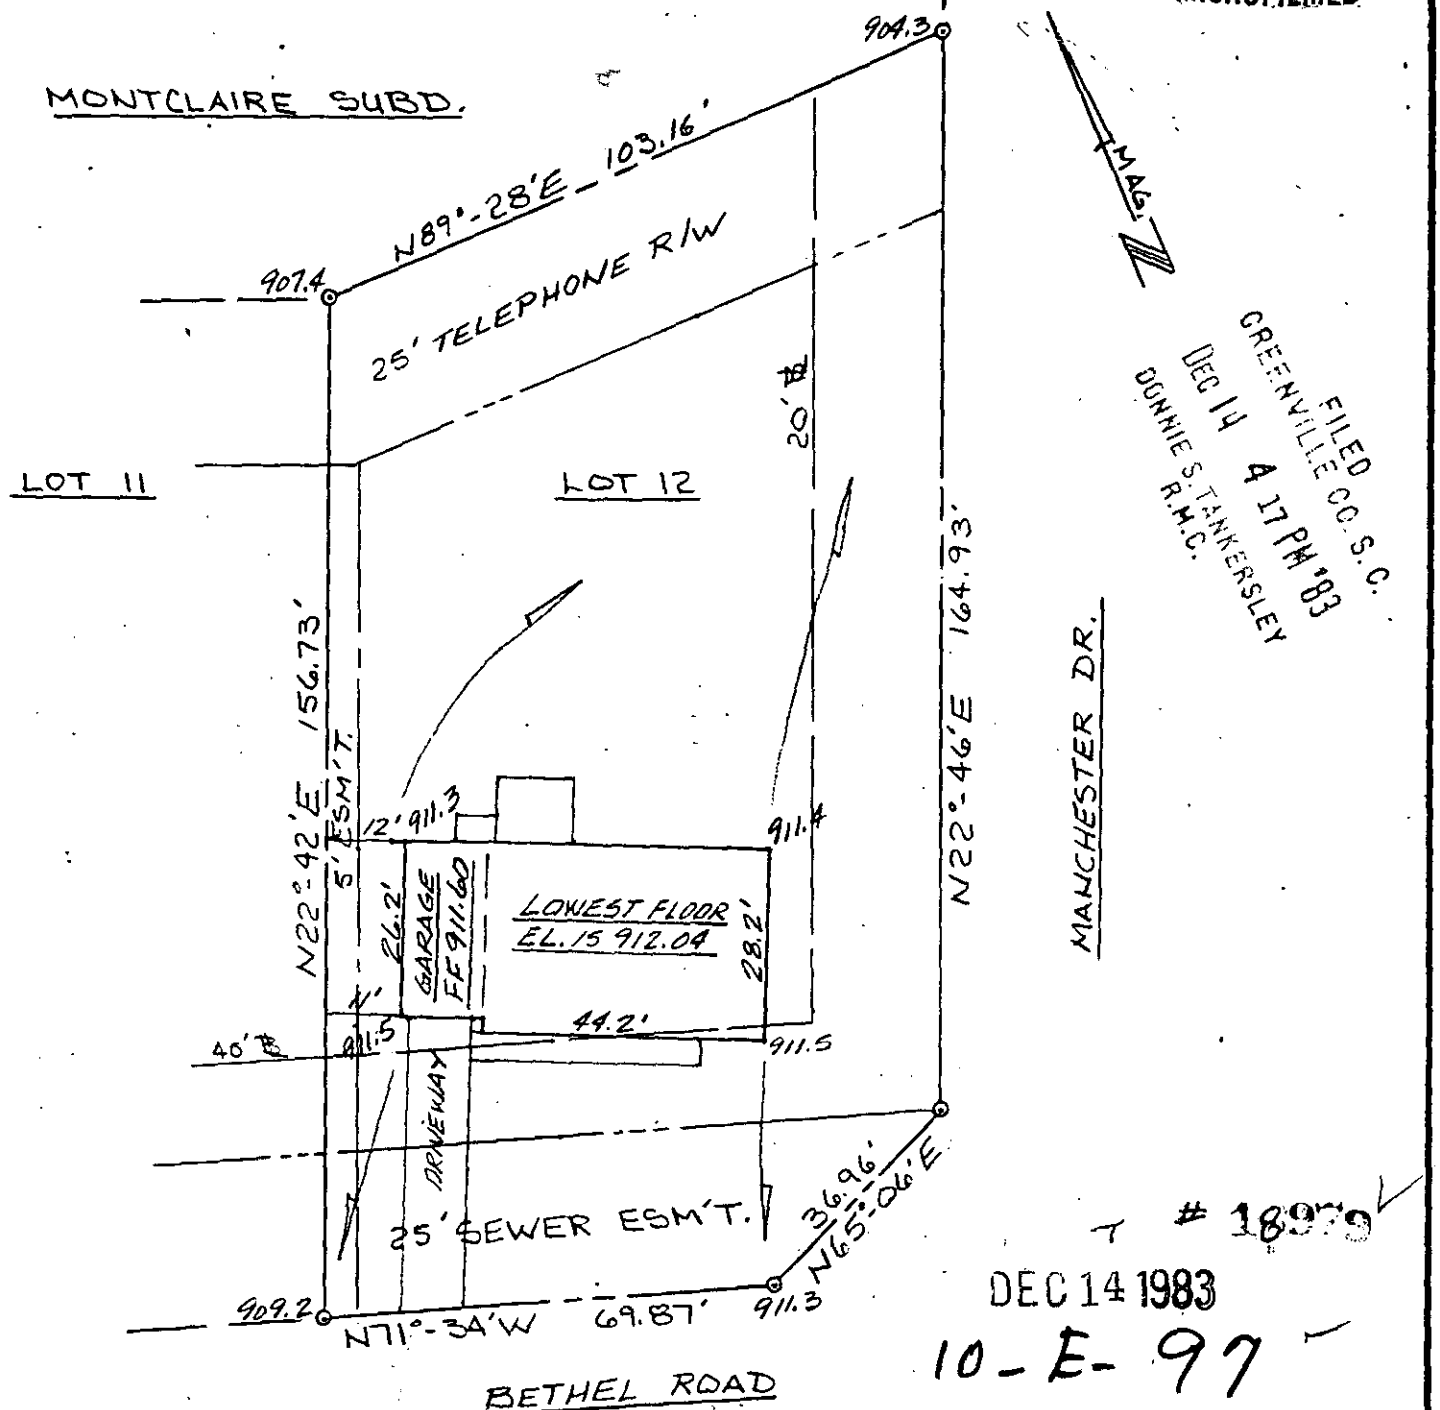

FILED
GREENVILLE CO. S.C.
DEC 14 4 17 PM '83
DONNIE S. TANKERSLEY
R.M.C.

1899

DEC 14 1983

10-E-97

Greenville County
South Carolina

Date: December 5, 1983
Scale: 1" = 30'

Plat and building location of Lot 12, Forest Trail, recorded in Plat Book ____, Page ____, Office of R.M.C., belonging to Gary S. Sassaman and Lisa Sassaman.

I hereby certify that the measurements as shown on this plat are correct and there are no encroachments or projections other than shown, and that the house is not subject to flooding.

SOUTH CAROLINA REGISTERED LAND SURVEYOR

Registered Land Surveyor, SC #6571

heaner engineering co., inc.
greenwood, s. c.

CCTO ------ 3 DEC 14 83 961 30 3.00CBO