

TOYOTA OF GREENVILLE, INC.

LOT 5

272-1-2

272-1-2.1

N 21° 09' W 264.80

N 64° 30' E 349.16

S 25° 30' E 32.37

PART LOT 4

N 64° 30' E 293.05

PART LOT 4

OLD LOT LINE 2

PART LOT 3

ASPH. DRIVE

SHED

HOUSE

CONC. WITH COVER

S 25° 30' E 60.00

S 64° 30' W 293.04

PART LOT 3

S 64° 30' W 369.00

LOT 2


SAN SEWER EASEMENT
SAN SEWER LINE
S 25° 25' E 171.67

LAURENS ROAD (US HWY 276)

317.1 ± TO E
PARKINS MILL RD.

21558

FILED
GREENVILLE CO. S.C.
JAN 10 12 14 PM '84
DUNNIE S. STARKERSLEY
R.M.C.

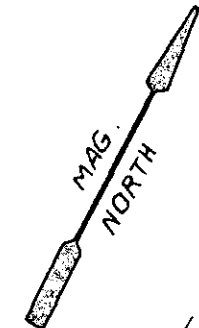


JAN 10 1984

10-F-60

This is to certify that on January 6, 1984, I surveyed the property shown on this plat, known as Part Lots 3 and 4 on Plat of Mary V. Harmon Property, recorded in the RMC Office of Greenville County in Plat Book N on Page 175, and that the property lines are as shown hereon; that the building located on said lots does not encroach or project on adjacent streets or property, and that no adjacent walls or buildings encroach or project on said premises, and that no utility lines cross this property except as shown hereon. This property is not located in a designated flood hazard area.

James R. Freeland
James R. Freeland RLS & PE 4781

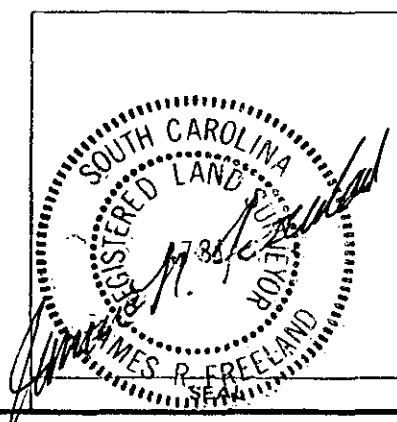

STATE OF SOUTH CAROLINA
GREENVILLE COUNTY

MARY V. HARMON PROP.
PART LOT 3 & PART LOT 4
PROPERTY OF
TERRY F. WALL

FREELAND & ASSOCIATES
Engineers • Land Surveyors

GREENVILLE, S.C.

SURVEY	L.T.
DRAWN	K.E.G.
CHECK	MC
SCALE	1" = 60'
DATE	1-6-84
DWG. NO.	10327

MICROFILMED