


DEC 22 9 34 AM '83

DONNIE S. TARKERSLEY R.M.C.

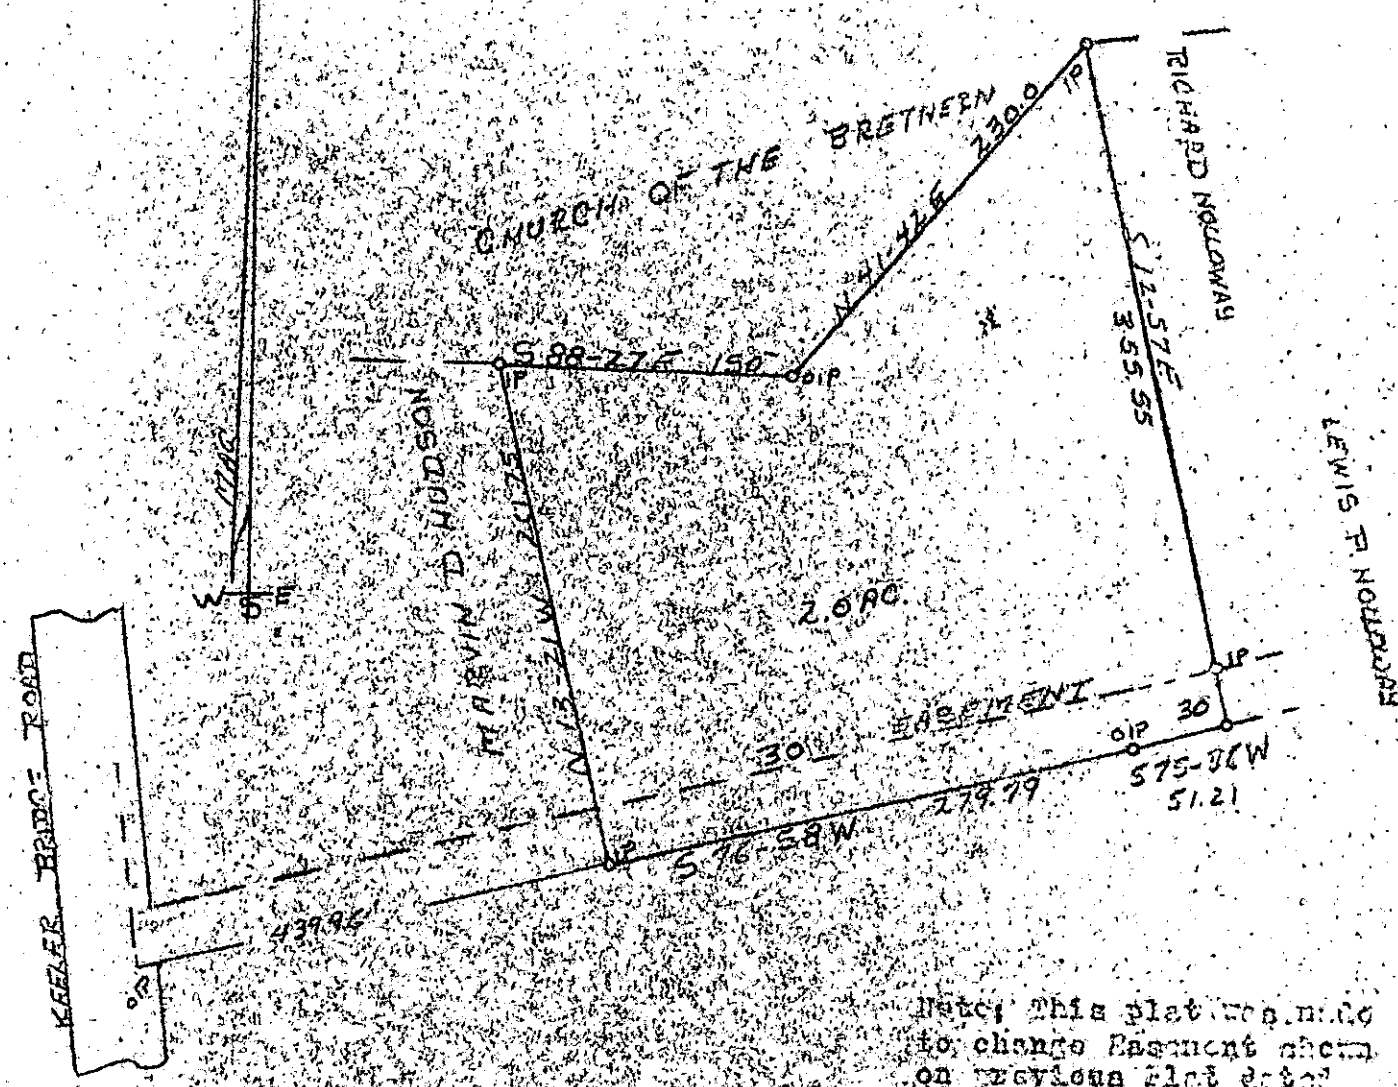

Date: This plat was made to change Easement shown on previous plat dated 2/2/83.

PROPERTY OF DAVID CHURCH

DEC 22 1983

State of South Carolina Greenville County

The above property is located approx three miles north of Forestville, Baptist Church.

Scale: 1" = 100'

10-G-16

Date 8/2/83

Survey Chief Frank Duncan

1983 ✓

*[Signature]*  
 T. DONNIE S. TARKERSLEY  
 R.M.C.

Reg. No. 1712 L. S.