


25' SAN. SEWER EASEMENT

GREENVILLE CO. S.C.
DEC 28 4 04 PM '83
DONNIE S. JAMMERSLEY
R.H.C.


577

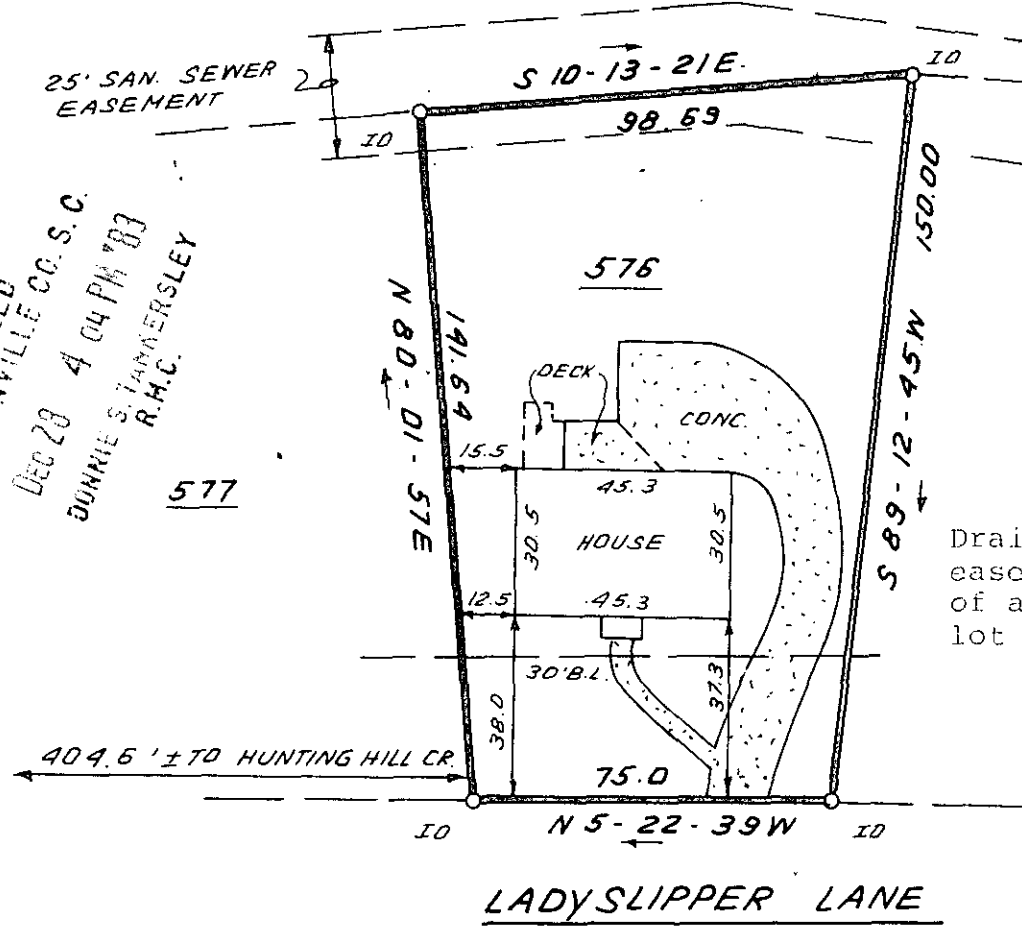

Drainage & utilities easement 5' each side of all side and rear lot lines.

DEC 28 1983

LOG-33 20285

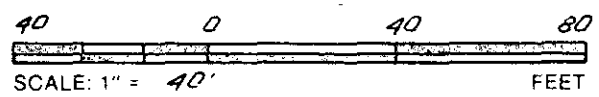

THIS IS TO CERTIFY THAT THE PROPERTY SHOWN ON THIS PLAT WAS SURVEYED UNDER MY DIRECT SUPERVISION. PROPERTY LINES AND IMPROVEMENTS SHOWN ARE LOCATED CORRECTLY AND THAT NO VISIBLE ENCROACHMENTS EXIST UNLESS OTHERWISE SHOWN. THIS PROPERTY IS NOT LOCATED IN A DESIGNATED FLOOD HAZARD AREA

James R. Freeland

SOUTH CAROLINA
REGISTERED LAND SURVEYOR
NO. 4781
JAMES R. FREELAND

PLS: JAMES R. FREELAND
NO: 4781

STATE OF SOUTH CAROLINA
GREENVILLE COUNTY

SUGAR CREEK
SEC. 2, LOT 576
PROPERTY OF
JAMES D. HAYES
HARRIET D. HAYES DE 28 83

FREELAND & ASSOCIATES
Engineers • Land Surveyors
318 WEST STONE AVENUE.
GREENVILLE, S.C.
(803) 271-4924

PLAT BOOK	BP - 62
DEED BOOK	
TAX MAP	538.17-1-68
PARTY CHIEF	MLC
DRAWN	BR
DATE	DEC. 23. 83
CD	031
DWG NO.	10, 263