
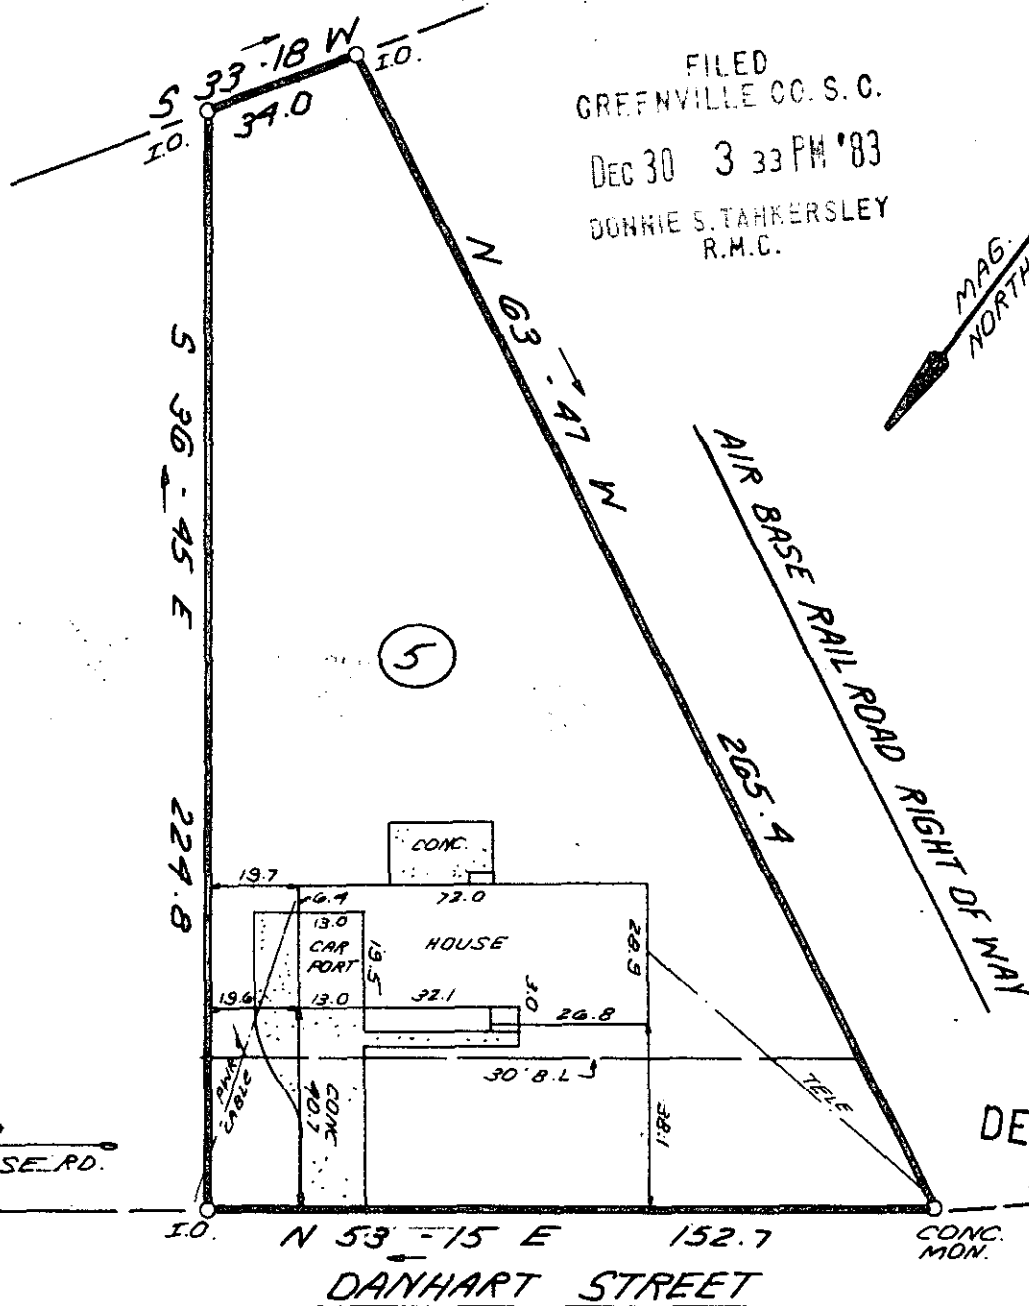


FILED
GREENVILLE CO. S. C.

DEC 30 3 33 PM '83

BONNIE S. TAKKERSLEY
R.M.C.

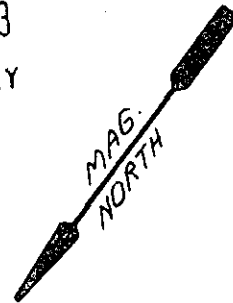

(4)

(5)

DEC 30 1983

693' ± TO
WHITE HORSE RD.



20537 ✓ 10 G-42

THIS IS TO CERTIFY THAT THE PROPERTY SHOWN ON THIS PLAT WAS SURVEYED UNDER MY DIRECT SUPERVISION. PROPERTY LINES AND IMPROVEMENTS SHOWN ARE LOCATED CORRECTLY AND THAT NO VISIBLE ENCROACHMENTS EXIST UNLESS OTHERWISE SHOWN. THIS PROPERTY IS NOT LOCATED IN A DESIGNATED FLOOD HAZARD AREA.

SOUTH CAROLINA REGISTERED LAND SURVEYOR
 4781
 JAMES R. FREELAND

PLS: JAMES R. FREELAND
 NO: 4781

**STATE OF SOUTH CAROLINA
 GREENVILLE COUNTY**

MARYDALE
LOT 5
 PROPERTY OF
JOHN DIXIE DAVIS
TERESA L. DAVIS

FREELAND & ASSOCIATES
 Engineers • Land Surveyors
 318 WEST STONE AVENUE.
 GREENVILLE, S.C.
 (803) 271-4924

PLAT BOOK	NY-107
DEED BOOK	908-183
TAX MAP	WG 6.1-1-57
PARTY CHIEF	D.G.
DRAWN	K.E.G.
DATE	12-29-83
DWG. NO	10293 0001