



MICROFILMED

FILED
GREENVILLE CO. S.C.
JAN 3 12 35 PM '84
DONNIE STANKERSLEY
R.M.C.

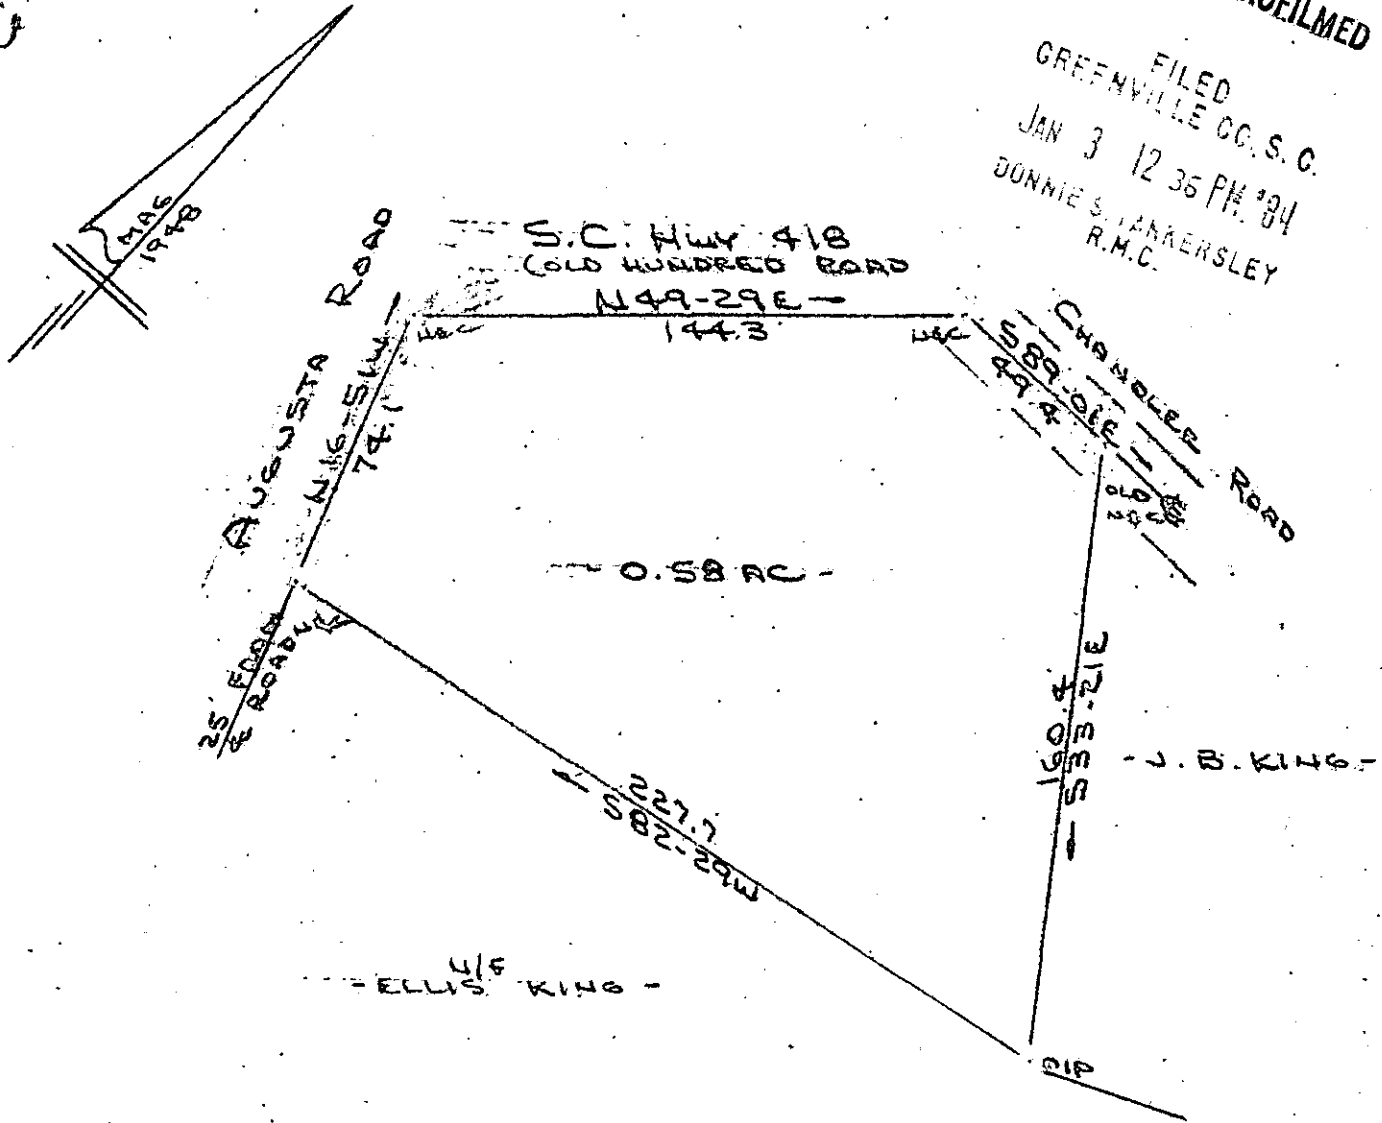

SURVEY FOR
GENE PATRICK
GREENVILLE COUNTY, S.C.
19 DEC 1983

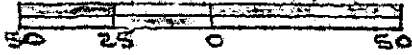

I Certify That The Ratio Of Precision Of The Field Survey
Is $1/3000^+$ As Shown Hereon And That The Area
Determined By D.M.D. Method Of Area Calculations.

20810 ✓

10-G-49


R. B. Brubaker
R.M.C.



CAROLINA SURVEYING Co.
112 MAIN ST
GREENVILLE, S.C.

Recordable Plat

LOCATION MAP
1/4" SCALE

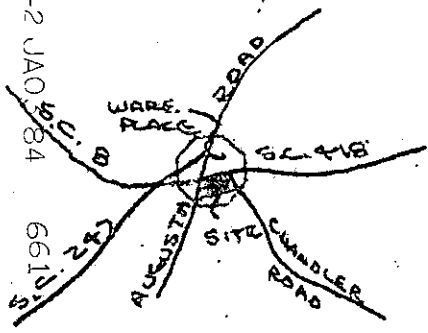

3.0001