
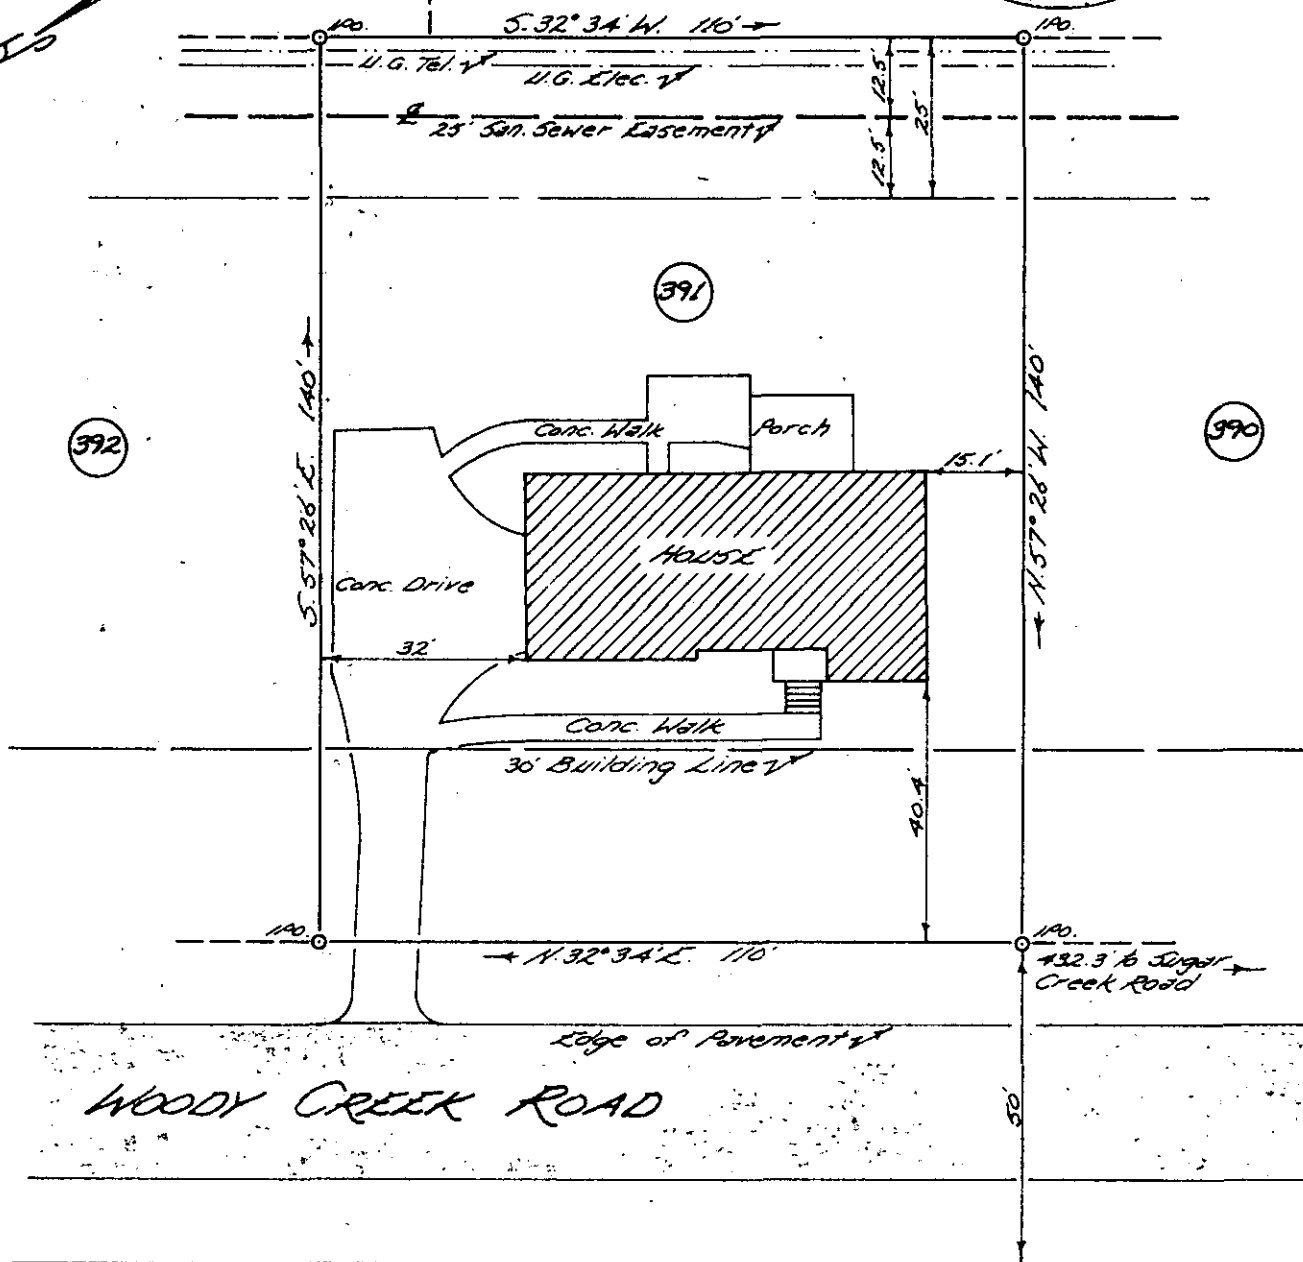


JAN 10 1984

58

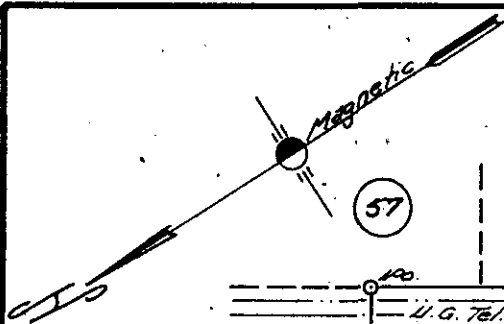

PROPERTY OF 10-G-61  
ROBERT G. & PATRICIA U. FREDERICK

Located near Greenville

GREENVILLE COUNTY, SOUTH CAROLINA

SCALE: 1" = 30 FEET

DEC. 28, 1983

21559



This is to certify that on December 27, 1983, I surveyed the property shown on this plat, and the same is correct, being shown as Lot No. 391, on plat of Sugar Creek, Map No. 1 Section No. 2, recorded in Plat Book 7C at Page 68, also see Plat Book 7Z at Page 68, and that the property lines, walls and building shown thereon on said lot do not encroach or project on adjacent streets or property, and that no adjacent buildings or walls encroach or project on said premises. This property is not located in a Flood Plane.



*John A. Simmons*

Registered Surveyor in S.C. #2212

300 3 11A01