MICROFILMED

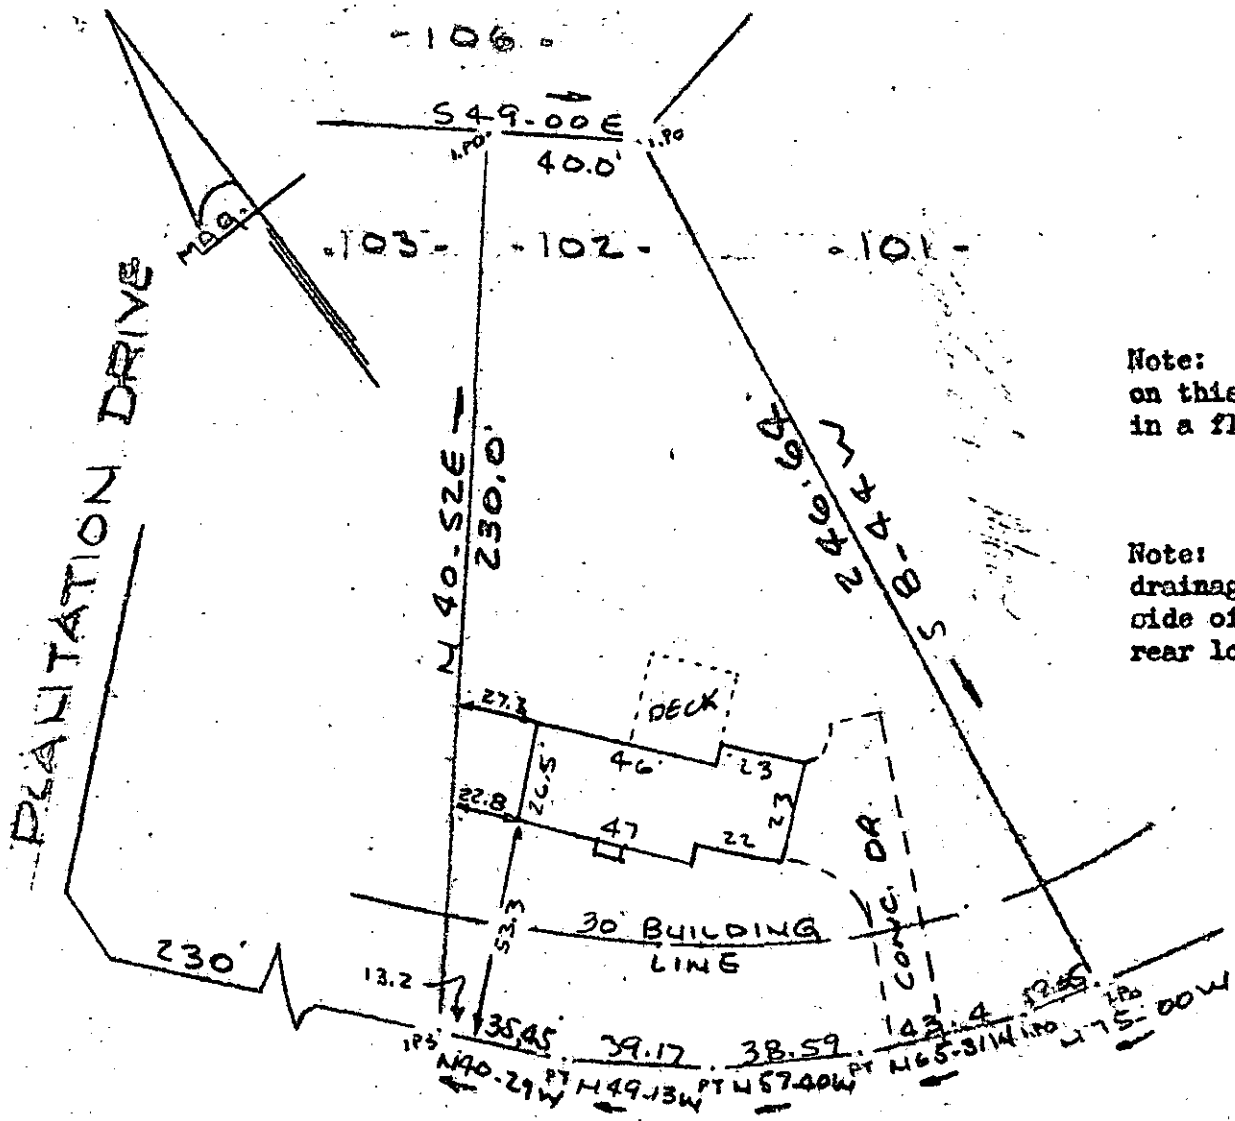

Note: Improvements on this lot are not in a flood hazard area.

Note: 5 ' utility & drainage easement each side of all side & rear lot lines.

RED OAK COURT
WATER & SEWER IN ST R/W

PROPERTY OF
CHARLES B. MOORE & JANE MOORE
NEAR GREENVILLE, S.C.
SCALE 1" = 50' 10 JAN 1984

FILED
GREENVILLE CO. S.C.
JAN 13 3 32 PM '84
DONNIE S. TANKERSLEY
R.M.C.

This is to certify that on the 10th day of January, 1984, I surveyed the property shown on this plat, being known as lot 102 on plat of HOLLY TREE PLANTATION PHASE II SECTION III and recorded in the RMC Office Greenville County, S. C., in Plat Book " 6 - H " at Page 10; and that the property lines, walls and buildings are as shown hereon, and that the walls and buildings located on said lot do not encroach or project on adjacent street or property, and that no adjacent walls or buildings encroach or project on said premises, and no power lines cross this property except as shown hereon.

10-G-73 21917 ✓

JAN 13 1984

R. B. Bruce, RLS #1952

CAROLINA SURVEYING CO.
112 Manly St.
Greenville, S. C.

Recordable Plat

SCTO -----2 JA13 84 137 3.00CI