



FILED
GREENVILLE CO. S. C.
FEB 1 1 55 PM '84
DONNIE S. TANALERSLEY
R.M.C.

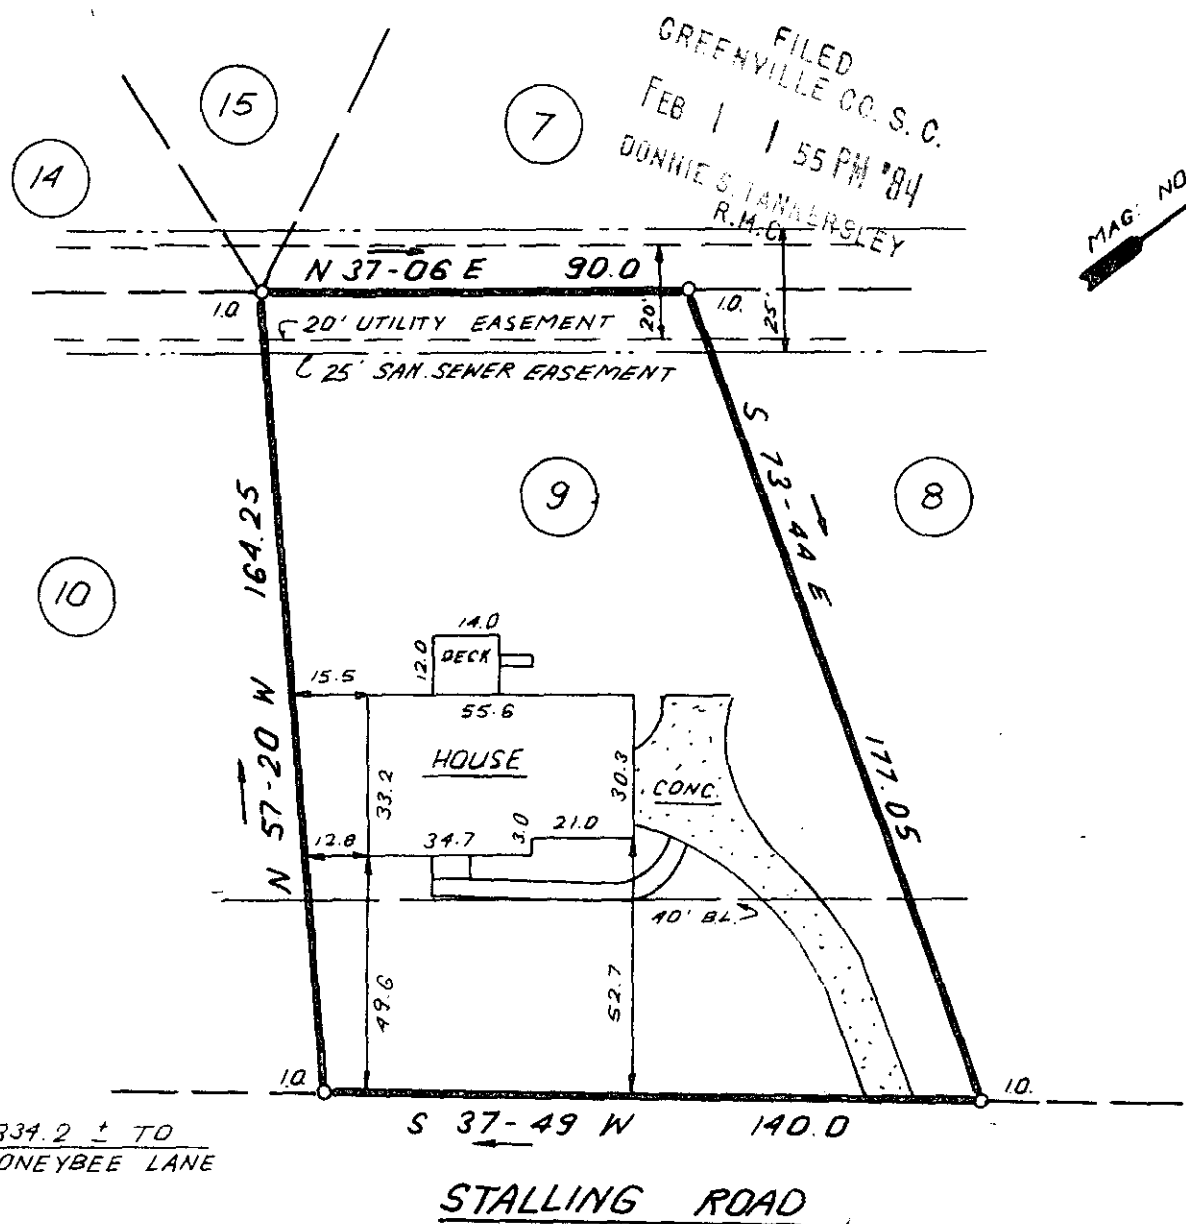

334.2 ± TO
HONEYBEE LANE

S 37-49 W 140.0
STALLING ROAD

23816 ✓ 10-H-27
FEB 1 1984

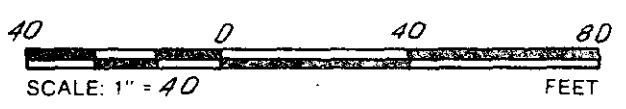

THIS IS TO CERTIFY THAT THE PROPERTY SHOWN ON THIS PLAT WAS SURVEYED UNDER MY DIRECT SUPERVISION. PROPERTY LINES AND IMPROVEMENTS SHOWN ARE LOCATED CORRECTLY AND THAT NO VISIBLE ENCROACHMENTS EXIST UNLESS OTHERWISE SHOWN. THIS PROPERTY IS NOT LOCATED IN A DESIGNATED FLOOD HAZARD AREA.

STATE OF SOUTH CAROLINA
GREENVILLE COUNTY

FREELAND & ASSOCIATES
Engineers • Land Surveyors
318 WEST STONE AVENUE.
GREENVILLE, S.C.
(803) 271-4924

PEBBLE CREEK
PHASE 1, LOT 9
PROPERTY OF

HUBERT R. WHITE
DAYATRA C. B. WHITE

PLAT BOOK	5 D - 5
DEED BOOK	1140 - 82
TAX MAP	525.6 - 1 - 9
PARTY CHIEF	J C
DRAWN	B.R.
DATE	1 - 19 - 84
DWG NO.	10,385



RLS: JAMES R. FREELAND
NO: 4781