


THE PRINT MACHINE, INC. N41289

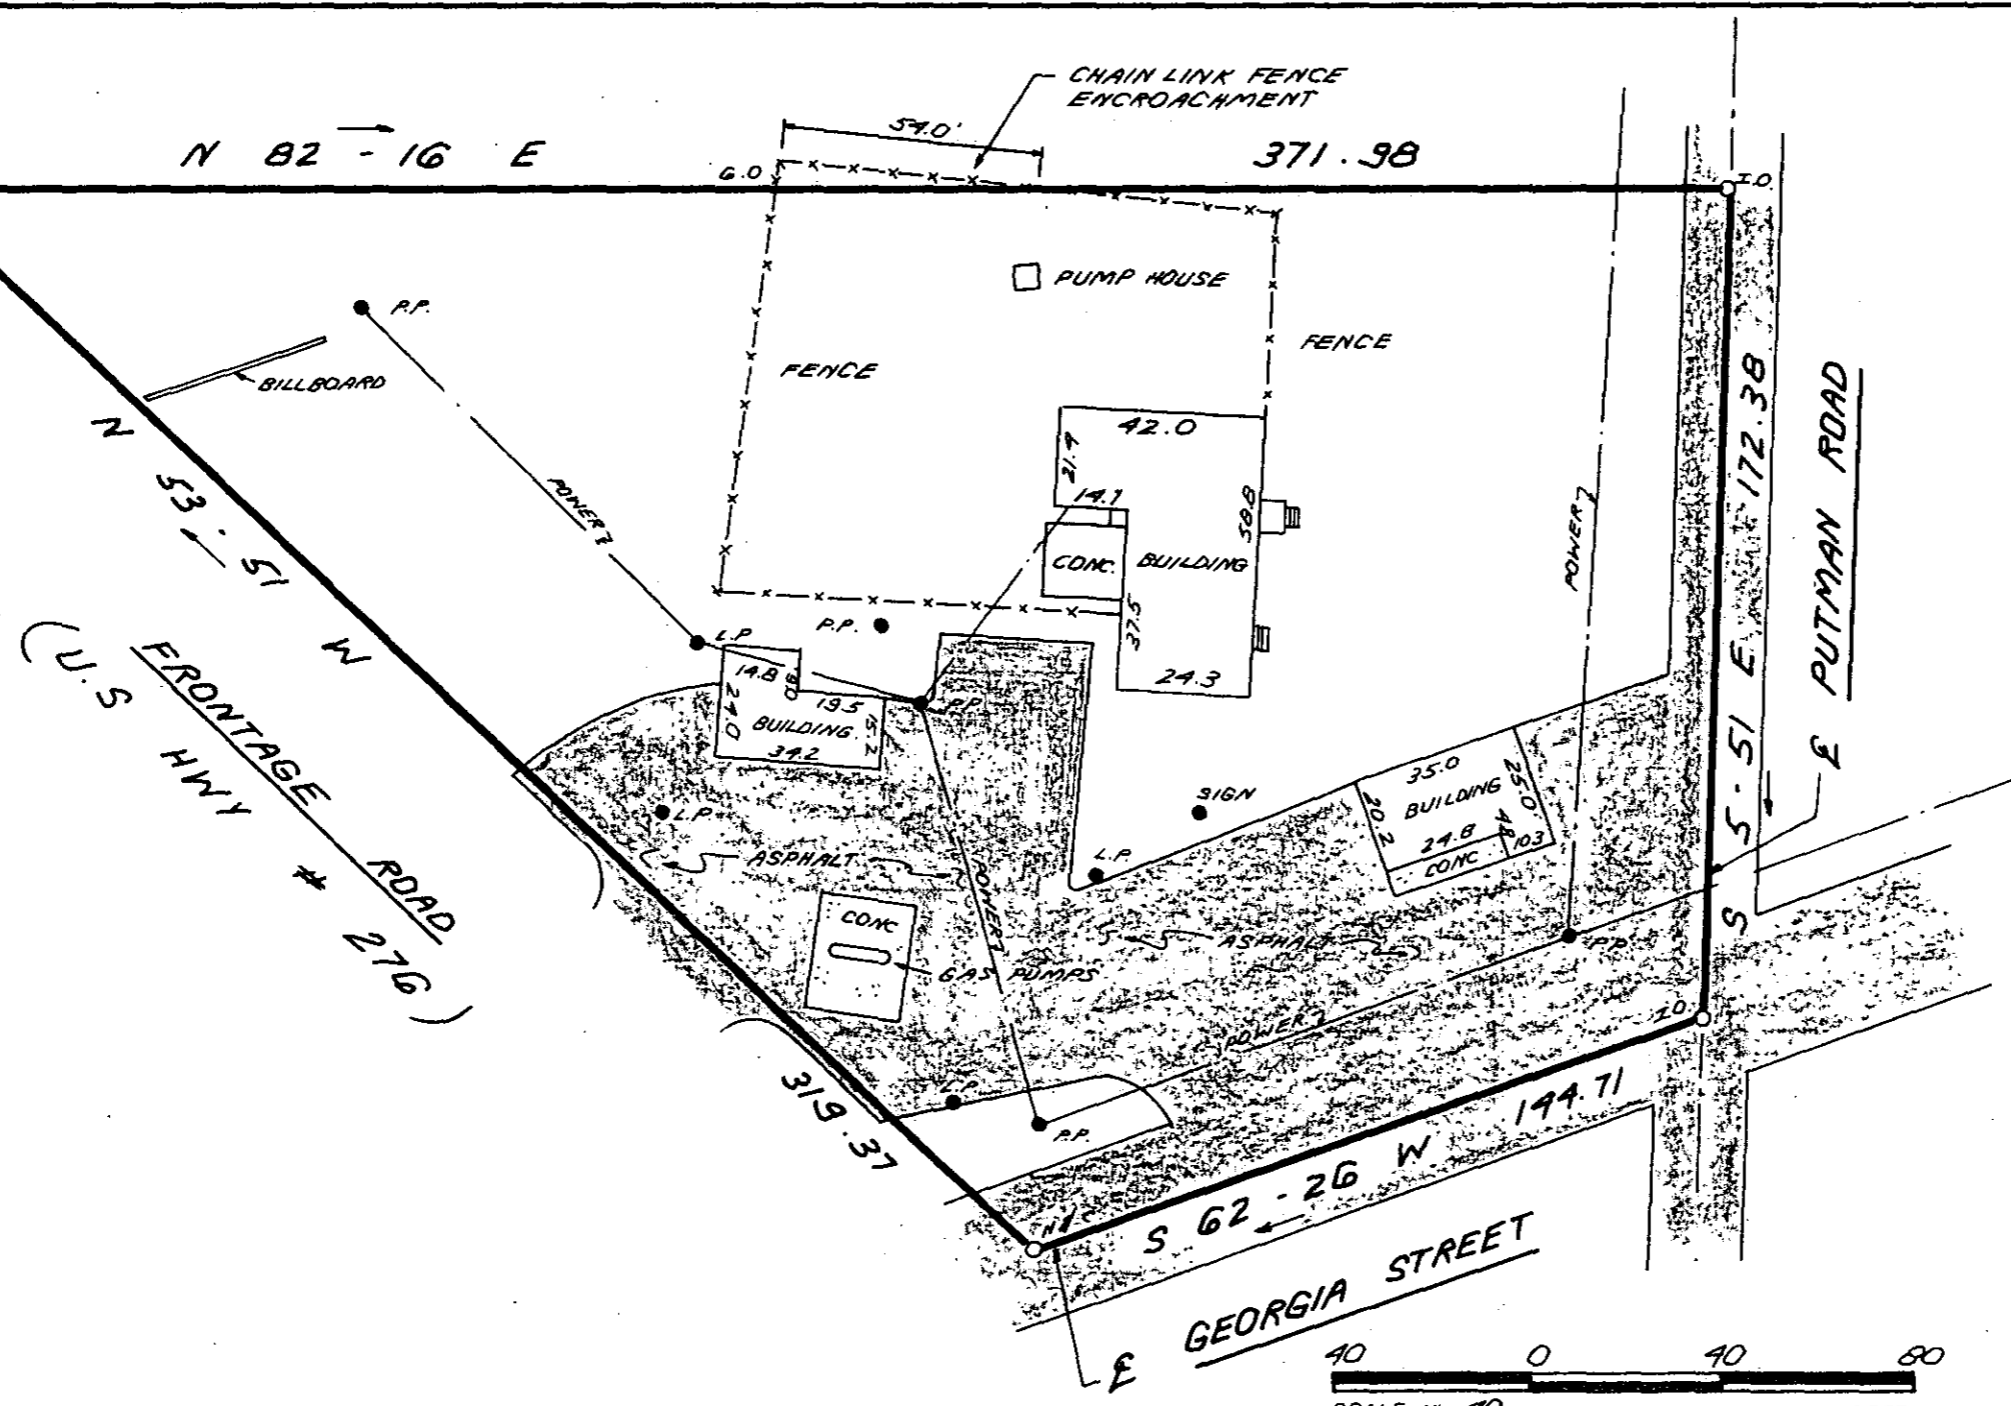

31788

APR 11 1984

10-I-99

SCALE: 1" = 40 FEET

THIS IS TO CERTIFY THAT THE PROPERTY SHOWN ON THIS PLAT WAS SURVEYED UNDER MY DIRECT SUPERVISION. PROPERTY LINES AND IMPROVEMENTS SHOWN ARE LOCATED CORRECTLY AND THAT NO VISIBLE ENCROACHMENTS EXIST UNLESS OTHERWISE SHOWN. THIS PROPERTY IS NOT LOCATED IN A DESIGNATED FLOOD HAZARD AREA.

FILED
 GREENVILLE CO. S.C.
 APR 11 4 40 PM '84
 DONNIE S. TARKERLEY
 R.M.C.

SOUTH CAROLINA
 REGISTERED LAND SURVEYOR
 4781
 JAMES R. FREELAND

STATE OF SOUTH CAROLINA
 GREENVILLE COUNTY

SURVEY FOR
 JAMES H. COBLE
 ECTO ----- 3 APR 11 84

FREELAND & ASSOCIATES
 Engineers • Land Surveyors
 318 WEST STONE AVENUE.
 GREENVILLE, S.C.
 (803) 271-4924

PLAT BOOK 310 121
 DEED BOOK 788 500
 TAX MAP 336-1-2
 PARTY CHIEF J.C.
 DRAWN K.E.G. O.C.C.
 DATE 4/6/84
 DWG. NO. 10854

MICROFILMED