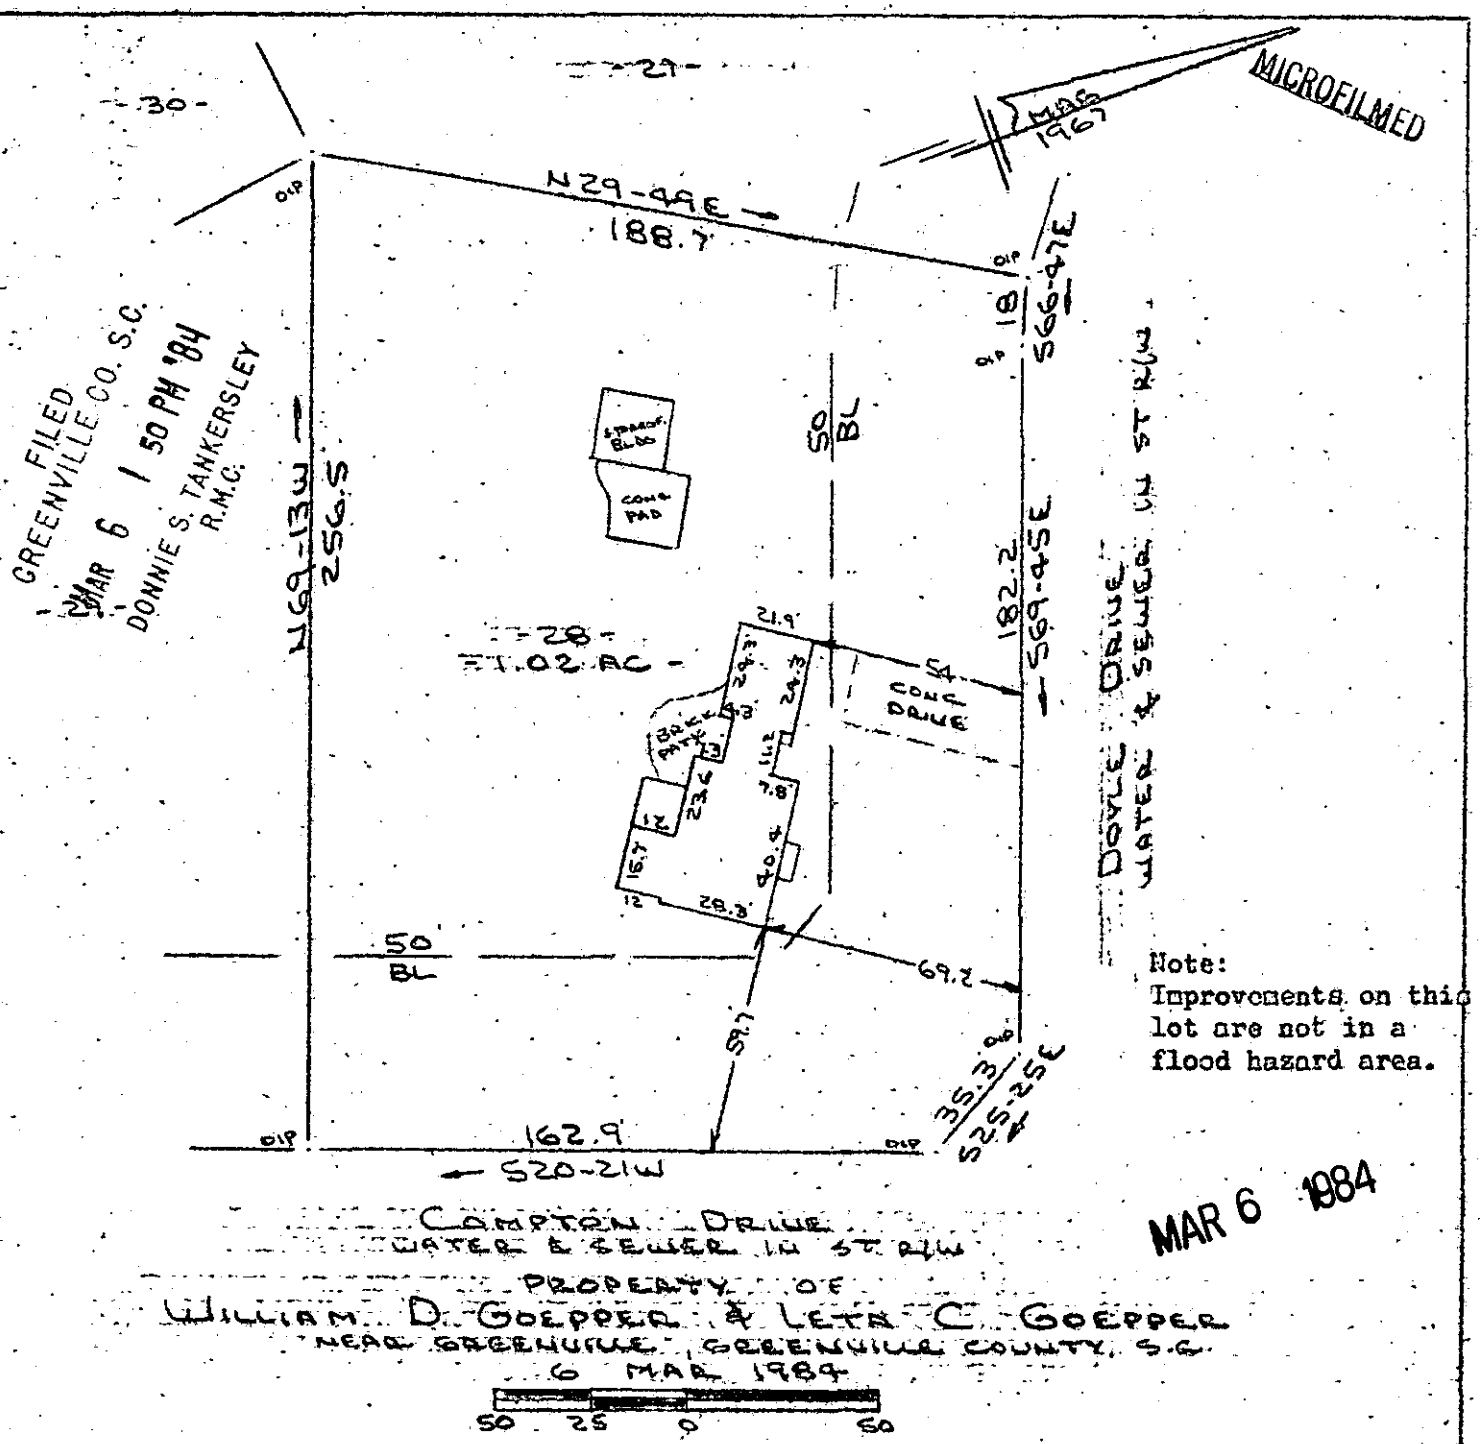

Note:
Improvements on this lot are not in a flood hazard area.

MAR 6 1984

CAMPTON DRIVE
WATER & SEWER IN ST R/W

PROPERTY OF
WILLIAM D. GOEPPER & LETA C. GOEPPER
NEAR GREENVILLE, GREENVILLE COUNTY, S.C.
6 MAR 1984

50 25 0 50

This is to certify that on the 6th day of March, 1984, I surveyed the property shown on this plat, being known as lot 28 (1.02 acres) on plat of TERRA PINES ESTATES SECTION 4 and recorded in the RMC Office Greenville County, S. C., in Plat Book " GGG " at Page 85; and that the property lines, walls and buildings are as shown hereon, and that the walls and buildings located on said lot do not encroach or project on adjacent street or property, and that no adjacent walls or buildings encroach or project on said premises, and no power lines cross this property except as shown hereon. Also known as PROPERTY OF WILLIAM D. GOEPPER & LETA C. GOEPPER and recorded in Plat Book at Page

R. B. Bruce

R. B. Bruce, RLS #1952

10J-44

27231

Recordable Plat

CAROLINA SURVEYING CO.
112 Manly St.
Greenville, S. C.

3.00CD

GCTO 3 MR 6 84 030

265/51