


MICROFILMED

FILED
GREENVILLE CO. S.C.

MAR 13 11 51 AM '84


DONNIE S. YANKERSLEY
R.M.C.

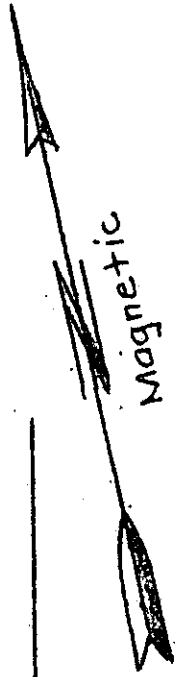

Note:
Improvements on
this lot are not
in a flood
hazard area.

Old Buncombe Road

Greeber Limited Partnership
1094 - 935

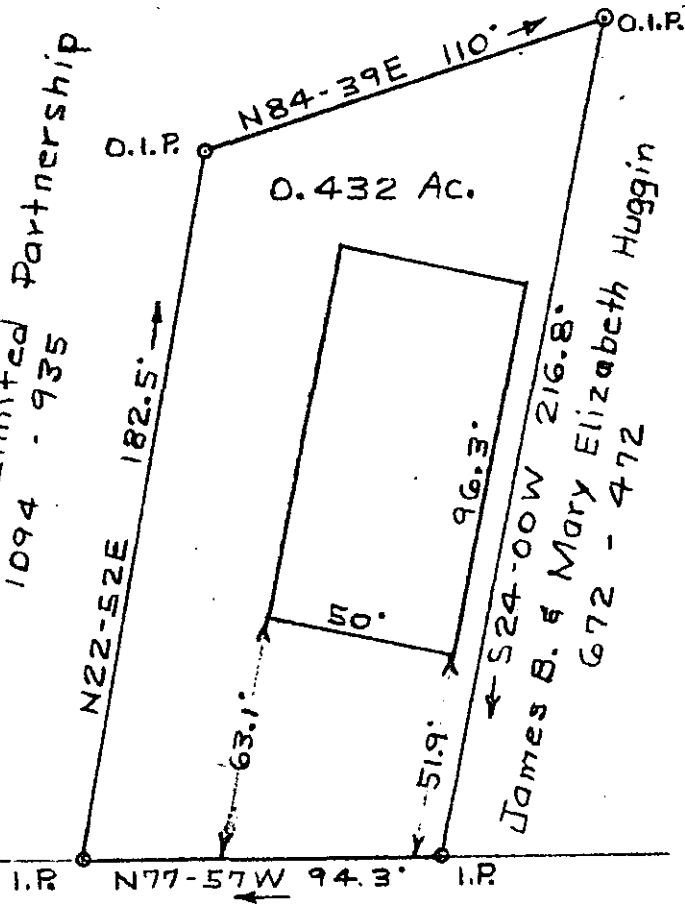

518.9'

North Franklin Road

PROPERTY OF
ROBERT LEWIS GOLDSMITH ET AL

GREENVILLE CO. S. C.

28095

Scale 1" = 50' Jan. 14, 1984



MAR 13 1984

Error of closure 1/10.703

This is to certify that on the 14th day of January, 1984, I surveyed the property shown on this plat, being the property described in Deed Book 1147 at page 550 and recorded in the Greenville County R.M.C. Office, and that the property lines, walls and buildings are as shown hereon, and that the walls and buildings located on said lot do not encroach or project on adjacent streets or property, and that no adjacent walls or buildings encroach or project on said premises, and that no power lines cross this property, except as shown.

10J-62

T.H. Walker Jr.
T.H. Walker Jr., Reg. L.S. No. 3182
300 Maple Drive
Mauldin, South Carolina 29662

Ref. Tax Map 162-1-4.1