


MICROFILMED

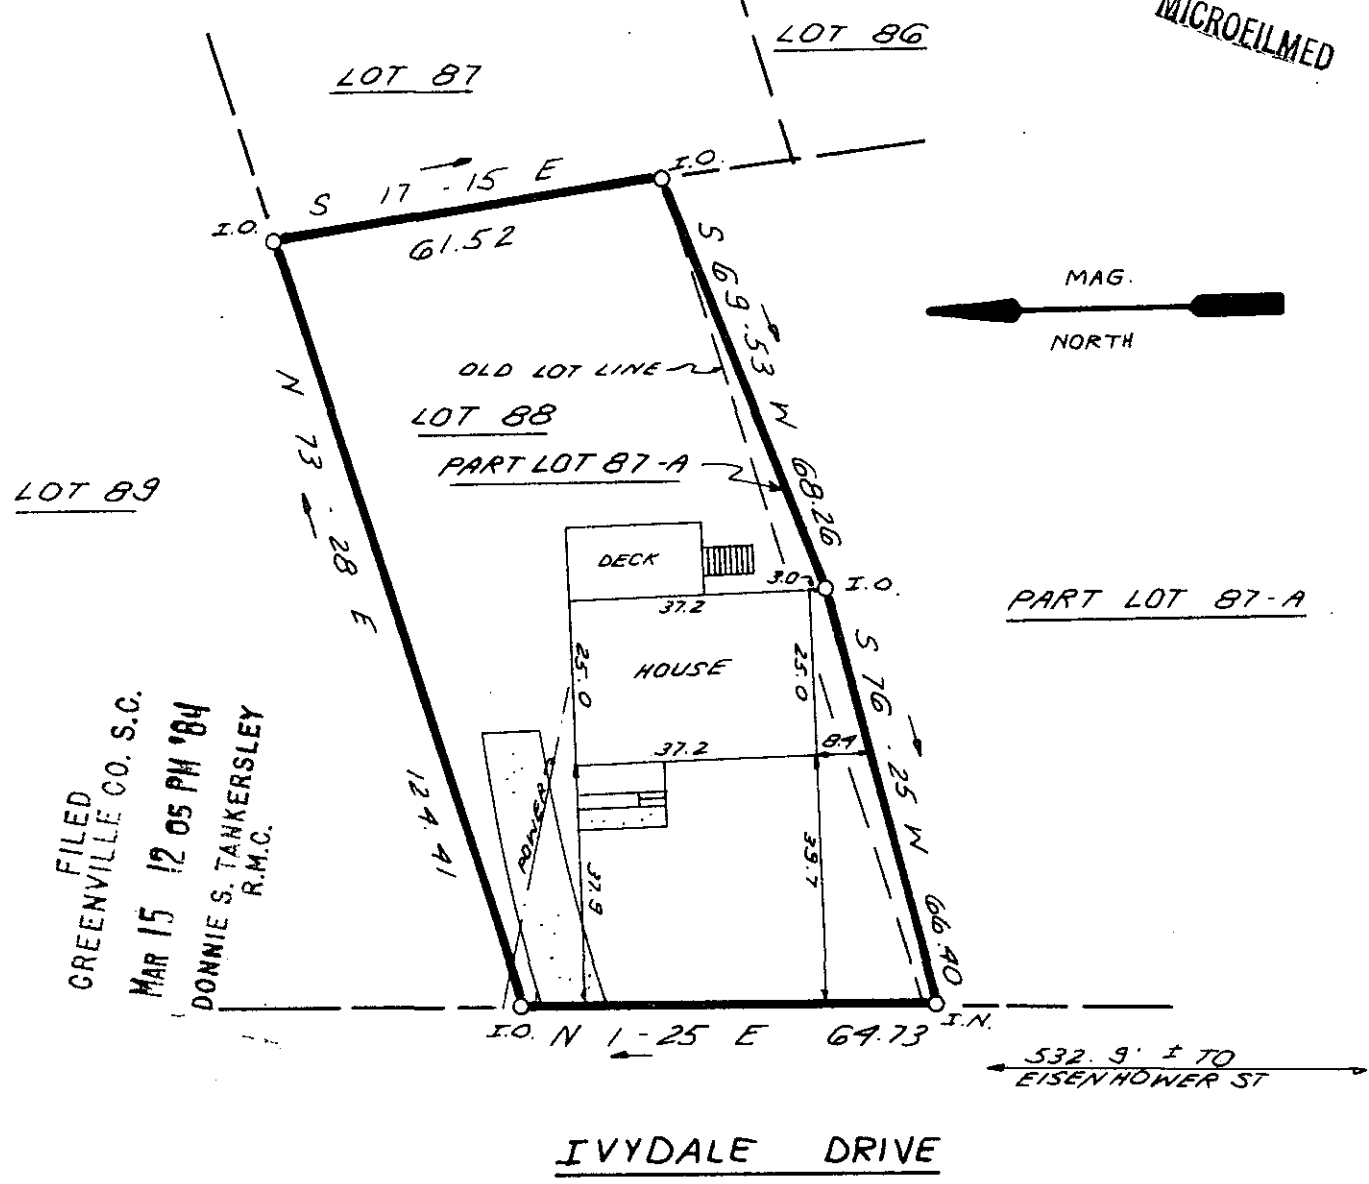

FILED
GREENVILLE CO. S.C.
MAR 15 12 05 PM '84
DONNIE S. TANKERSLEY
R.M.C.

28383 ✓

10-J-75

MAR 15 1984

THIS IS TO CERTIFY THAT THE PROPERTY SHOWN ON THIS PLAT WAS SURVEYED UNDER MY DIRECT SUPERVISION. PROPERTY LINES AND IMPROVEMENTS SHOWN ARE LOCATED CORRECTLY AND THAT NO VISIBLE ENCROACHMENTS EXIST UNLESS OTHERWISE SHOWN. THIS PROPERTY IS NOT LOCATED IN A DESIGNATED FLOOD HAZARD AREA.

SOUTH CAROLINA
REGISTERED LAND SURVEYOR
4781
JAMES R. FREELAND
JAMES R. FREELAND
S.L.S. JAMES R. FREELAND
NO. 4781

STATE OF SOUTH CAROLINA
GREENVILLE COUNTY

JOHN W. CAULEY PROP.
LOT 88 & PT LOT 87-A
PROPERTY OF
CHARLIE W. WILLARD
MARY E. WILLARD

FREELAND & ASSOCIATES
Engineers • Land Surveyors
318 WEST STONE AVENUE.
GREENVILLE, S.C.
(803) 271-4924

PLAT BOOK	WW-159
DEED BOOK	1039-437
TAX MAP	P 8-1-233
PARTY CHIEF	J.E.C.
DRAWN	K.E.G.
DATE	3-13-84
DWG. NO.	10691