
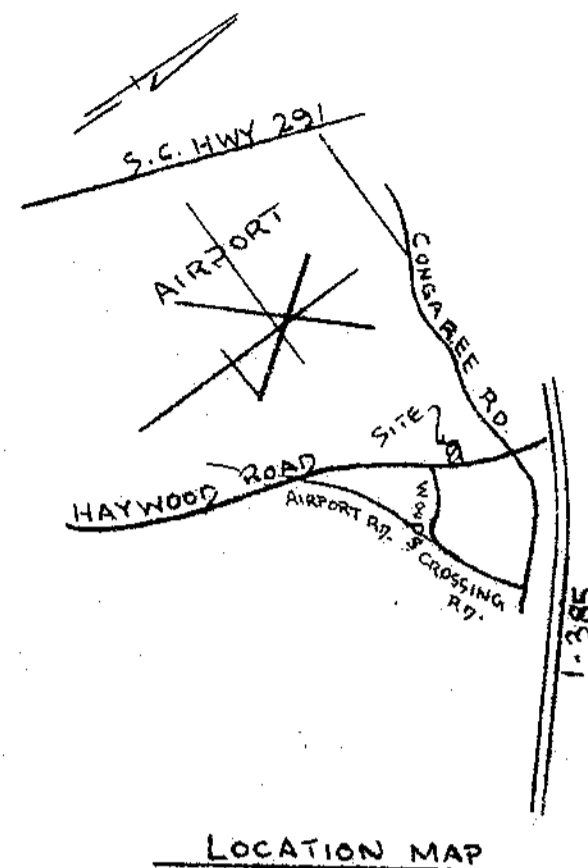


FILED  
GREENVILLE CO. S.C.  
APR 13 11 17 AM '84  
DONNIE S. BANKERSLEY  
D.M.C.

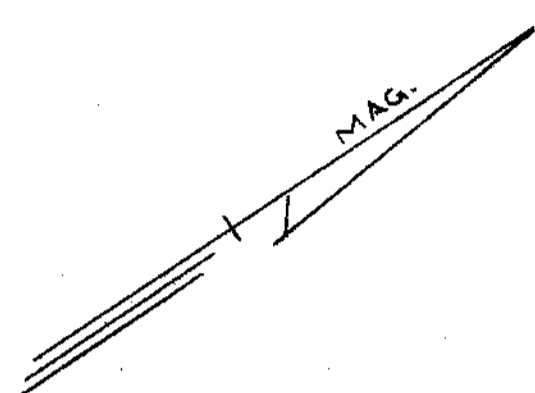

SAN. SEWER

C.P. ENTERPRISES


CLEANOUT

FIRST FEDERAL

BENNIGANS


PROPOSED ROAD

WOODS CROSSING ROAD

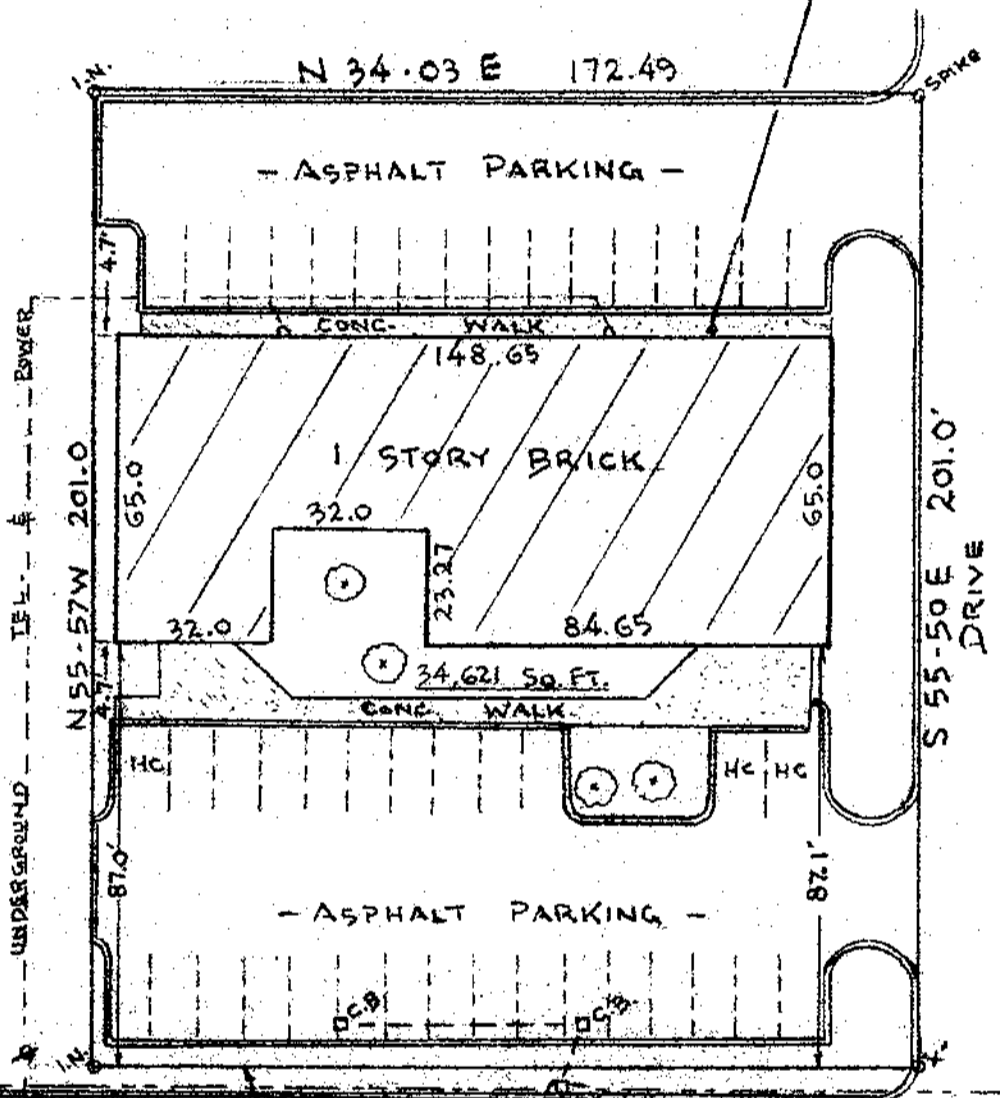

HAYWOOD ROAD


SURVEY FOR  
I.B.M. PRODUCT CENTER STORE  
GREENVILLE, S.C.  
SCALE 1"=40' APRIL 11, 1984

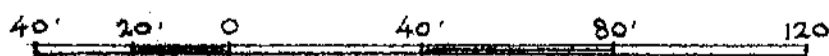

APR 13 1984

10K-38 32040 ✓

I HEREBY CERTIFY THAT THE MEASUREMENTS AS SHOWN ARE CORRECT & THERE ARE NO ENCUMBRANCES OR PROJECTIONS OTHER THAN SHOWN.

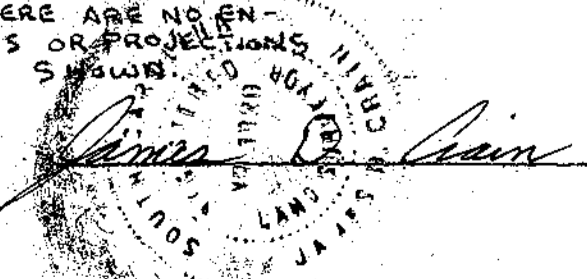

RLS No. 3320

PIEDMONT SURVEYORS  
GREENVILLE, S.C.

GO TO -- 1A1384 1412

5.0001