

MICROFILMED


FILED  
GREENVILLE CO. NORTH  
S.C.

APR 6 2 17 PM '84

MAG. DONNIE S. TANKERSLEY  
R.M.C.

NOTE: C. CREEK IS  
PROP. LINE.

80.2  
N 36-43E-

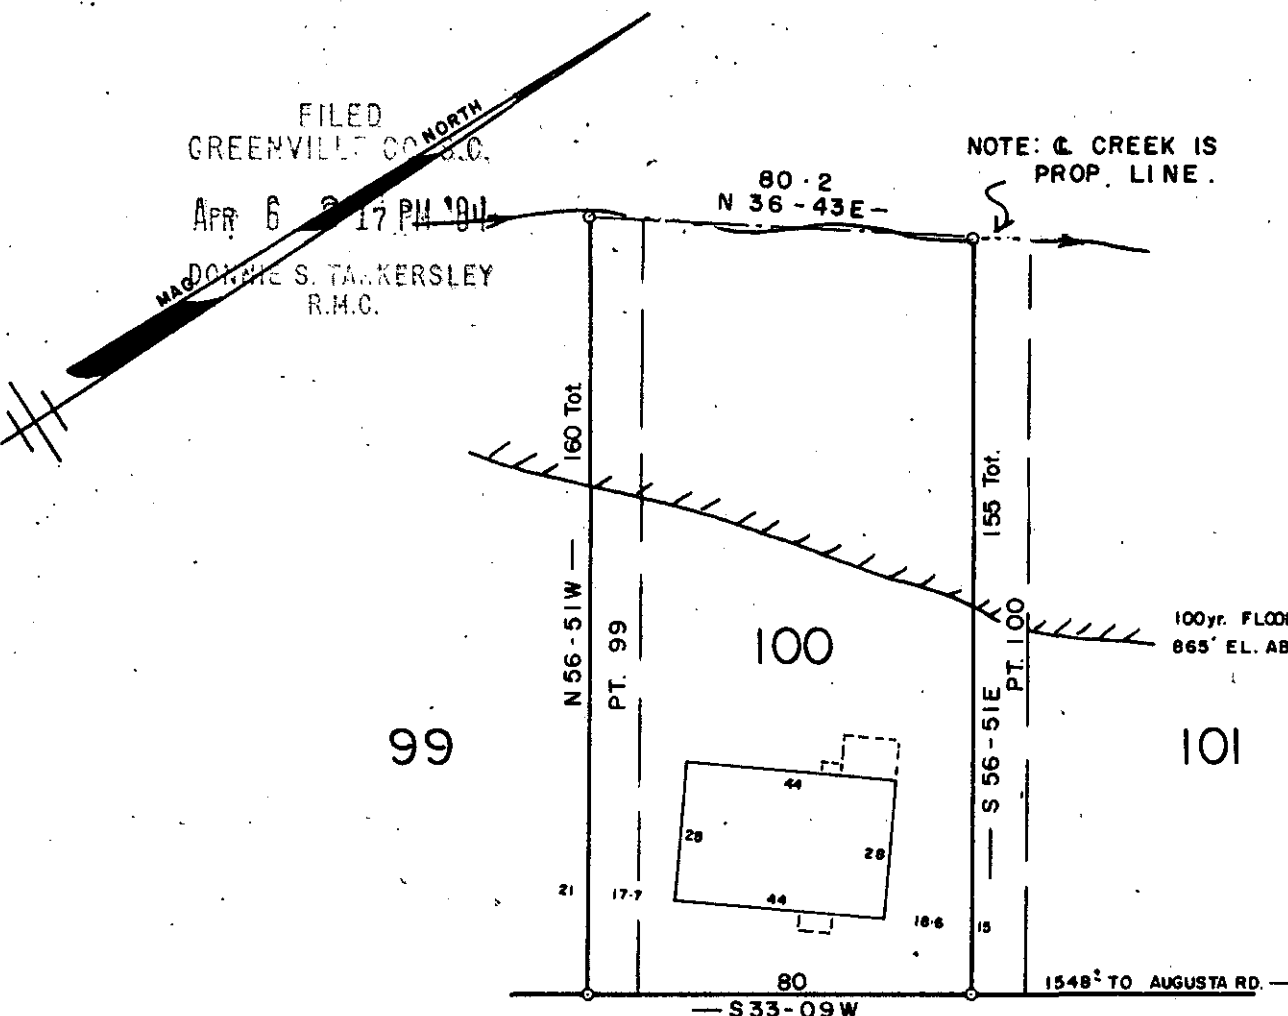


100yr. FLOOD PLANE  
865' EL. ABOVE SEALEVEL.

99

100

101

FAIRMONT AVE.

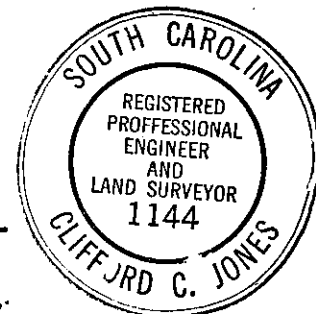

NOTE: House does not lie in a flood plane.

31254 APR 6 1984

10-2-68

This is to certify that on the \_\_\_\_\_ day of FEB, 1984, I surveyed the property shown on the plat, being PLOT 99 & 100, BROOKFOREST of the R.M.C. Office for Greenville County, S. C., and that the property lines, walls and buildings are as shown hereon; that the buildings located on said lot do not encroach or project on adjacent streets or property; and that no adjacent buildings or walls encroach or project on said premises, and that no utility lines cross this property.

*Clifford C. Jones*  
Reg. Engineer No. 1144 S.C.

JONES ENGINEERING SERVICE

PROPERTY OF

FRED G. HATHAWAY

GREENVILLE COUNTY, S. C.

FEB. 1 - 1984.

0 25 50 100

3 APR 6 84 022 SCALE 1"=40' 3.0000

1006 E. PERRY RD. G'VILLE S.C.