


MICROFILMED

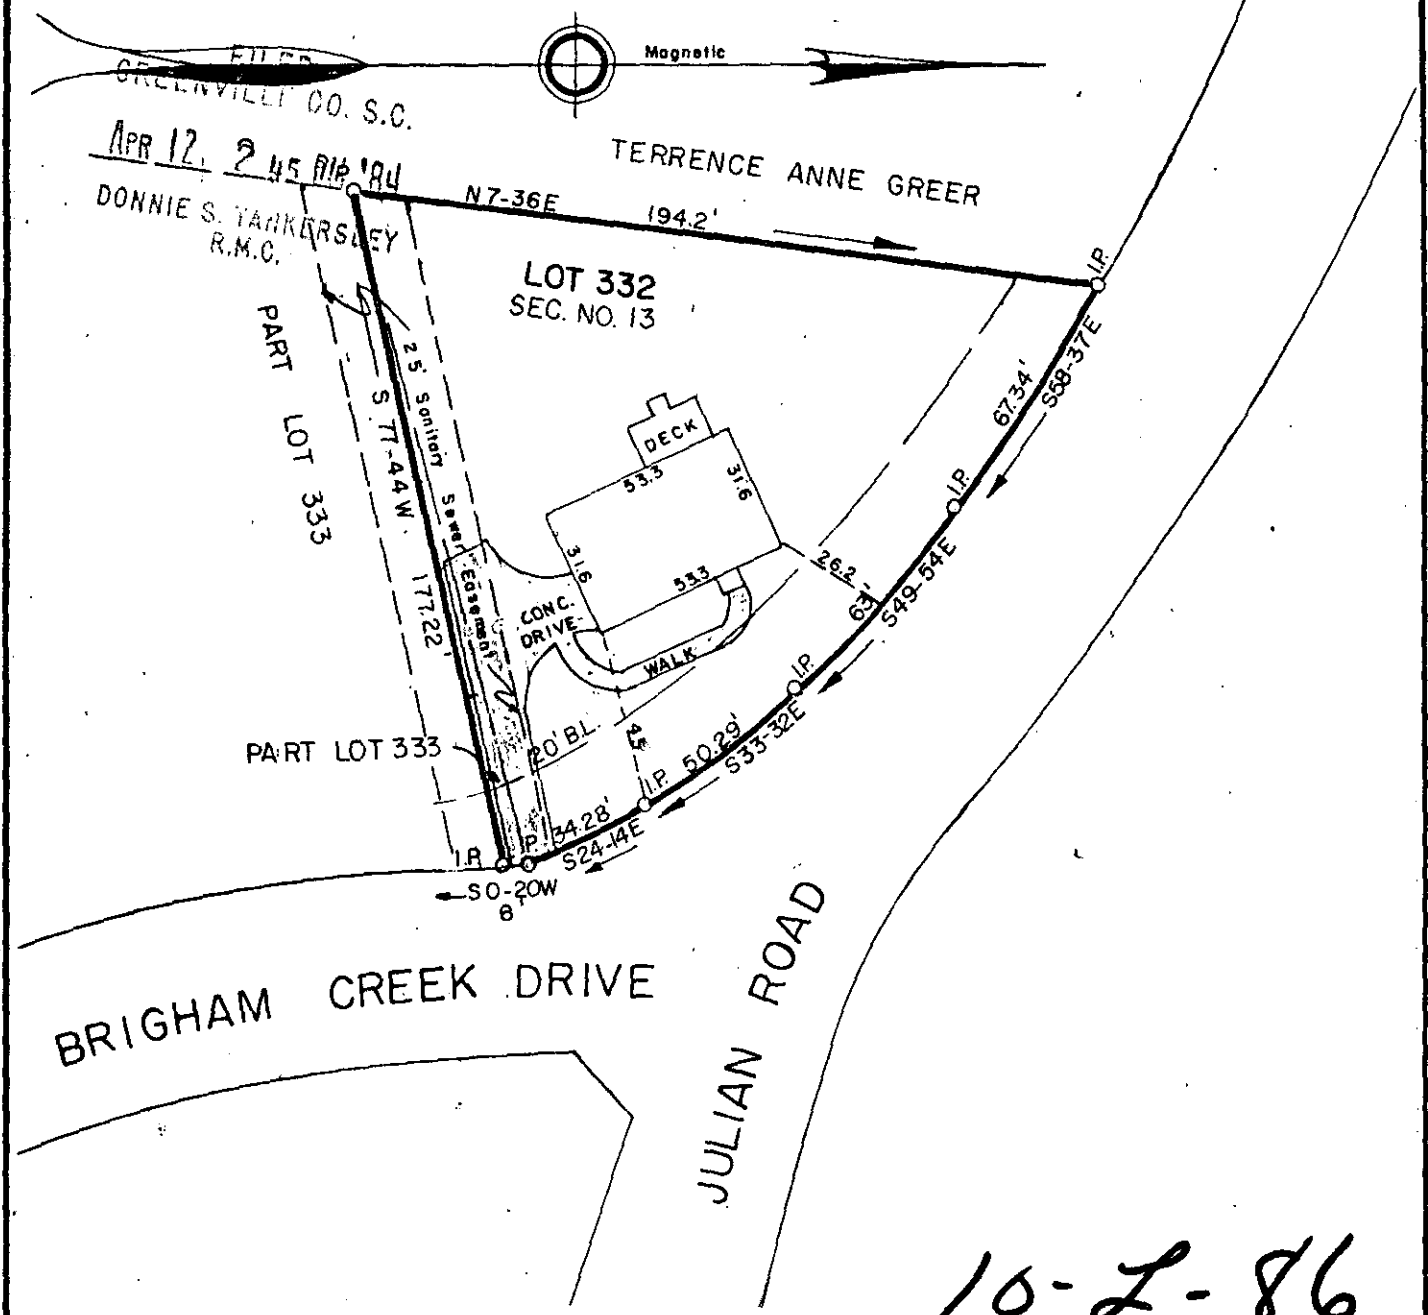

10-L-86

PROPERTY OF
PAUL R. CALKINS
BETH A. CALKINS
 GREENVILLE COUNTY, S. C.

APR 12 1984

31917

Scale 1" = 50' March, 1984

This is to certify that on the 15th day of March, 1984, we surveyed the property shown on this plat being known as Lot 332 and Part Lot 333 on plat of Devenger Place, Section No. 13, recorded in plat book 8-P, page 12, Office of R.M.C., Greenville County, S.C.; and that the property lines, walls and buildings are as shown hereon; that the buildings located on said lot do not encroach or project on adjacent streets or property; and that no adjacent buildings or walls encroach or project on said premises; and from information from Greenville County, this structure is not in a designated flood area.

R. W. Dalton
 DALTON & NEVES CO., INC. ENGINEERS