

MICROFILMED


WATTS AVENUE
WATER & SEWER IN ST R/W

FILED
GREENVILLE CO. S.C.

APR 12 4 38 PM '84

DONNIE S. YANKERSLEY
R.M.C.

MBS
1947

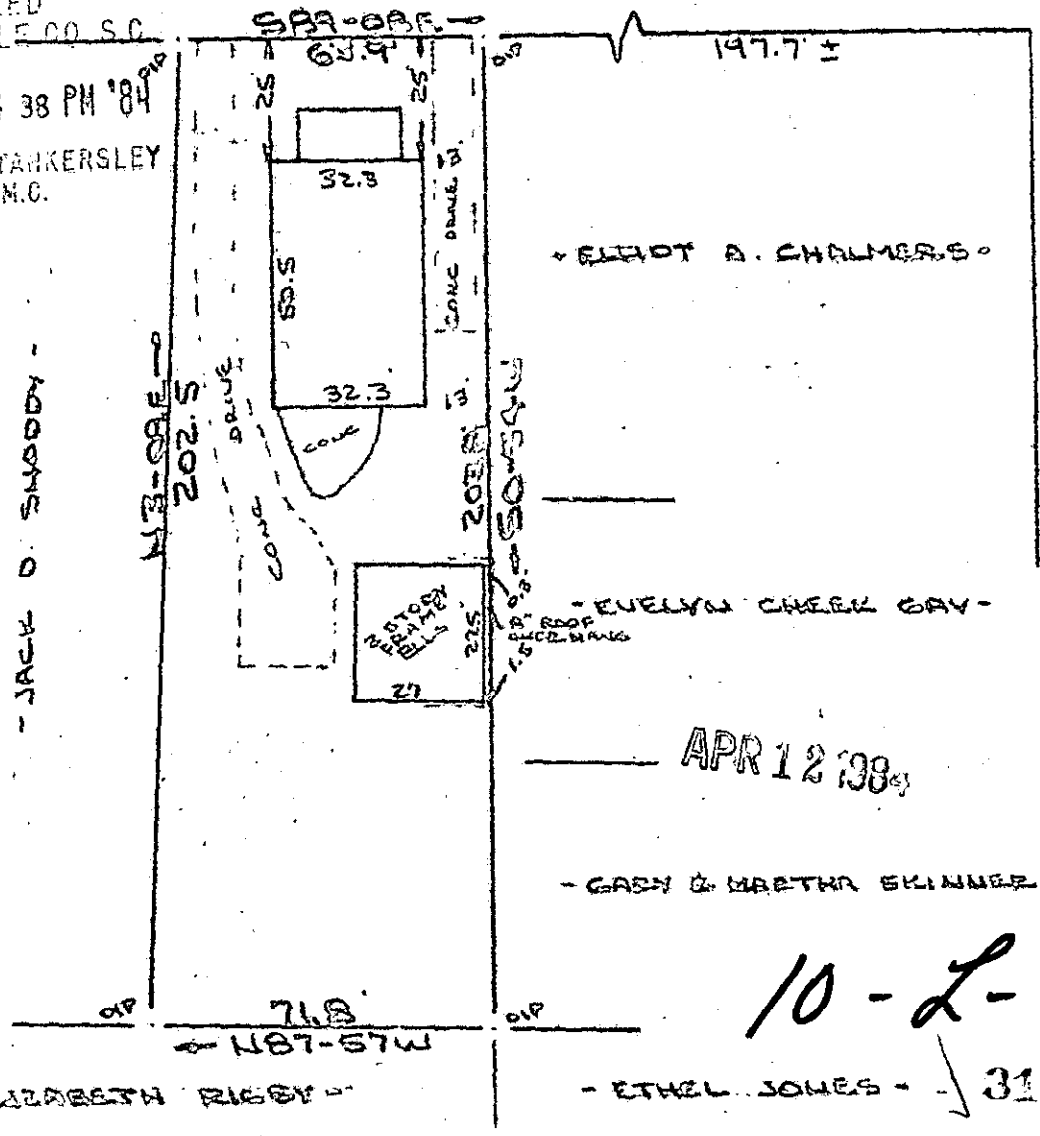


Note:
Improvements
on this lot
are not in a
flood hazard
area.

APR 12 1984

10-L-88

31952

PROPERTY OF
E. A. RAMSAUR, JR. & KAREN B. RAMSAUR
GREENVILLE COUNTY, GREENVILLE, S.C.
SCALE: 1"=40' 4 APR 1984

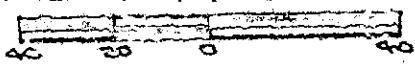

This is to certify that on the 4th day of April, 1984, I, surveyed the property shown on this plat, being known as PROPERTY OF E. A. RAMSAUR, JR. & KAREN B. RAMSAUR and recorded in the REC Office Greenville County, S. C., in Plat Book " " at Page " and that the property lines, walls and buildings are as shown hereon, and that the walls and buildings located on said lot do not encroach or project on adjacent street or property, and that no adjacent walls or buildings encroach or project on said premises, and no power lines cross the property except as shown hereon.

Recordable Plat

R. B. Brubaker
 R. B. Brubaker
 058
 3.0000
 APR 12 1984

GO TO ---3 AP12 84

CAROLINA SURVEYING CO.
112 Eady St., Greenville, S.C.