

PROPERTY OF
CARMEN J. FINCHER & REBECCA L. FINCHER

Located in Greer

GREENVILLE COUNTY, SOUTH CAROLINA

SCALE: 1" = 20 FEET MAY 1, 1984




This is to certify that on May 1, 1984, I surveyed the property shown on this plat, and the same is correct, being shown as Lot No. 80, on plat of Westmoreland Circle, and that the property lines, walls and building shown thereon on said lot do not encroach or project on adjacent streets or property, and that no adjacent buildings or walls encroach or project on said premises. This property is not located in a Flood Plane.

MAY 1 1984

John A. Simmons

Registered Surveyor in S.C. #2212

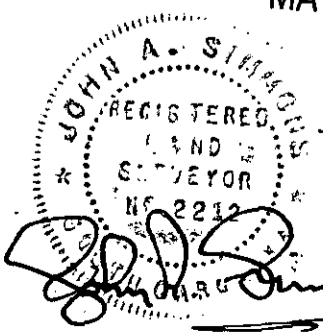

10-N-36

34201

Tri-State Surveyors
109 Few Street
Greer, S. C. 29651

5075 -- 1 MY 184 1067 5.0001