


MICROFILMED

N/F  
PENDRAVIS


WEST GEORGIA ROAD

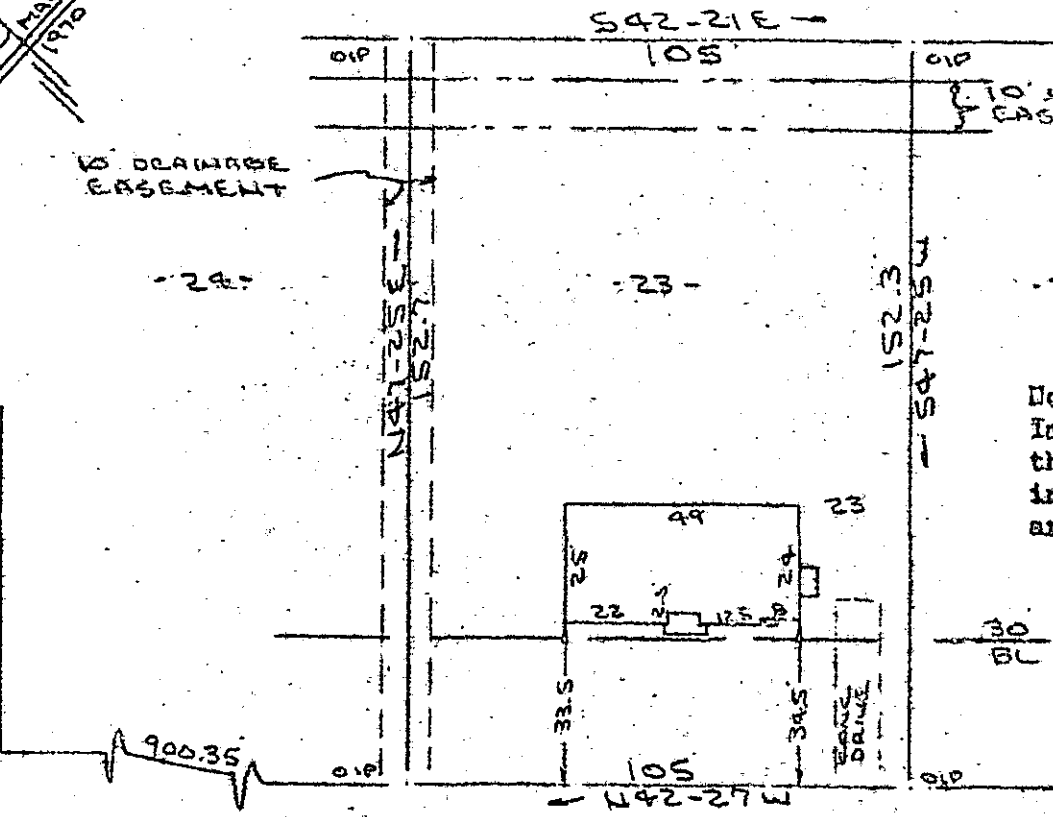

Note:  
Improvements on  
this lot are not  
in a flood hazard  
area.

WESTWOOD DRIVE  
WATER & SEWER IN STRIP

PROPERTY OF  
GEORGE E. DUGGON  
SIMPSONVILLE, S.C.  
9 APR 1984

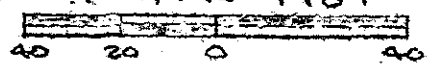

This is to certify that on the 9th day of April, 1984, I surveyed the property shown on this plat, being known as lot 23 on plat of SECTION NO. 1 WESTWOOD and recorded in the REC Office Greenville County, S. C., in Plat Book "4 - F" at Page 21; and that the property lines, walls and buildings are as shown hereon, and that the walls and buildings located on said lot do not encroach or project on adjacent street or property, and that no adjacent walls or buildings encroach or project on said premises, and no power lines cross this property except as shown hereon.

32339

*R. B. Bruce*  
R. B. Bruce, S.S. 1952

Recordable Plat

GREENVILLE CO. S.C.  
FILED  
APR 17 2 13 PM '84  
CAROLINA SURVEYING CO.  
112 Manly St.  
Greenville, S. C.

10-0-6

SC17  
1 APR 17 84  
020  
3:00CT