




FILED
GREENVILLE CO. S. C.
APR 18 8 46 AM '84
DONNIE S. TANKERSLEY
R.M.C.

BOXWOOD LANE

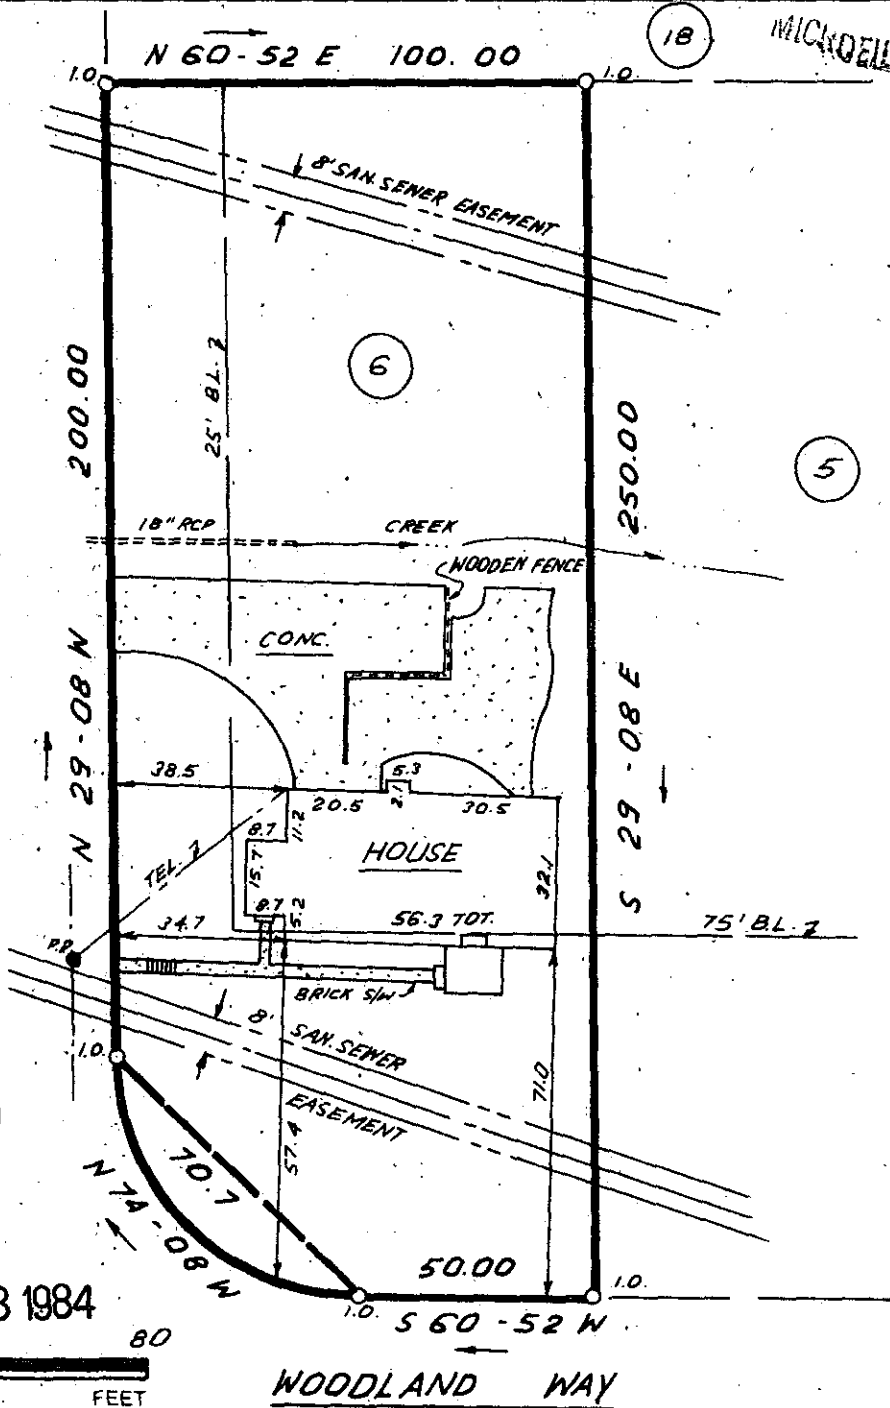

32529

10-0-8

APR 18 1984

SCALE: 1" = 40 FEET

THIS IS TO CERTIFY THAT THE PROPERTY SHOWN ON THIS PLAT WAS SURVEYED UNDER MY DIRECT SUPERVISION. PROPERTY LINES AND IMPROVEMENTS SHOWN ARE LOCATED CORRECTLY AND THAT NO VISIBLE ENCROACHMENTS EXIST UNLESS OTHERWISE SHOWN. THIS PROPERTY IS NOT LOCATED IN A DESIGNATED FLOOD HAZARD AREA.

STATE OF SOUTH CAROLINA
GREENVILLE COUNTY

FREELAND & ASSOCIATES
Engineers • Land Surveyors
318 WEST STONE AVENUE.
GREENVILLE, S.C.
(803) 271-4924

BOXWOOD MANOR

LOT 6

PROPERTY OF

CARL C. TRICKETT

JESSIE C. TRICKETT 18 84

004

PLAT BOOK BB - 85
DEED BOOK 1191-18 (1050-41)
TAX MAP 67.4 - 4 - 1
PARTY CHIEF B.C.
DRAWN B.R.
DATE 4-11-84
DWG. NO. 10871

RLS: JAMES R. FREELAND
NO: 4781