MICROFILMED

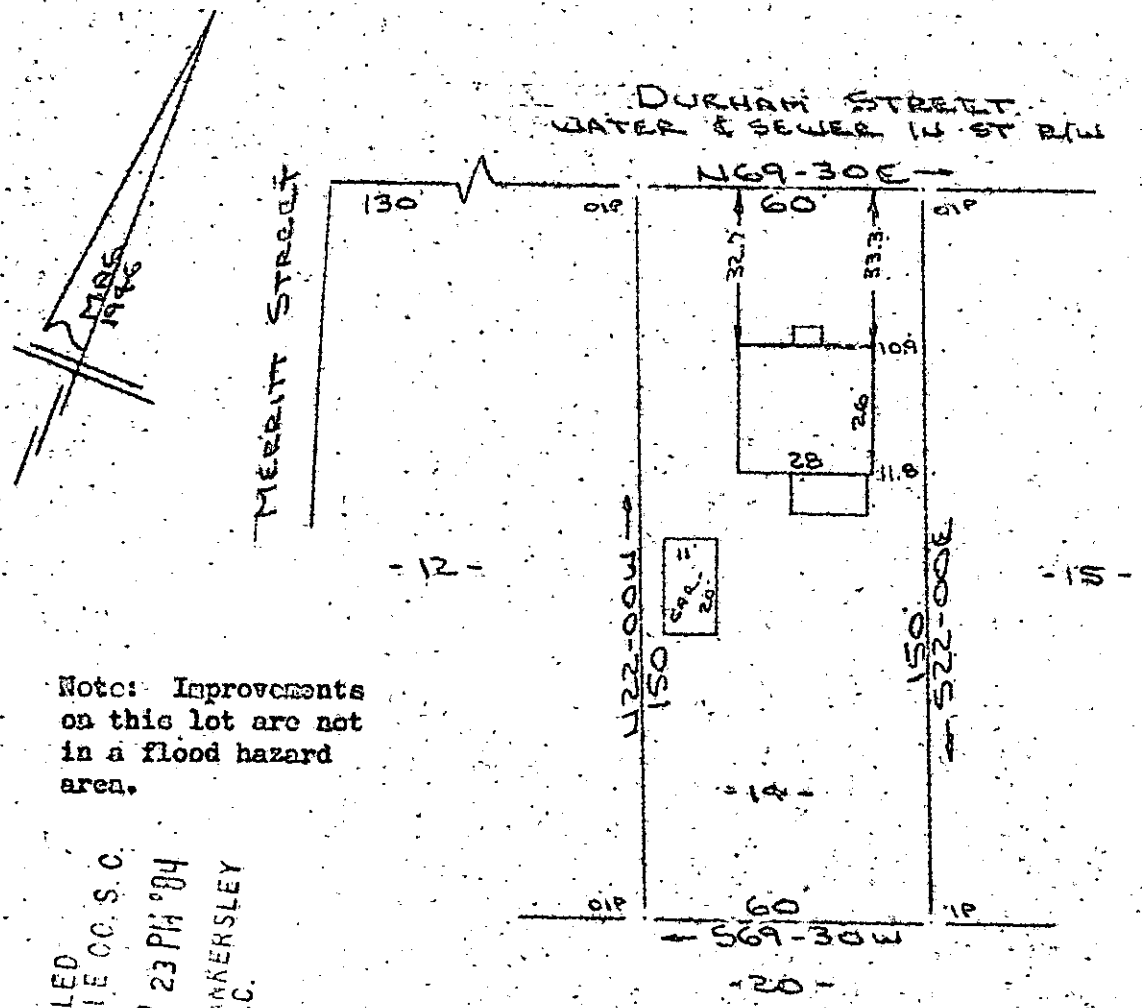

Note: Improvements on this lot are not in a flood hazard area.

FILED
GREENVILLE CO. S. C.
APR 24 12 23 PM '84
DONNIE S. TANKERSLEY
R.M.C.

PROPERTY OF
PETER J. EMANUEL
NEAR GREENVILLE, S.C.
19 APR 1984

This is to certify that on the 19th day of April, 1984, I surveyed the property shown on this plat, being known as lot 14 on plat of CENTRAL REALTY CORP. and recorded in the RMC Office Greenville County, S. C., in Plat Book " B " at Page 199; and that the property lines, walls and buildings are as shown hereon, and that the walls and buildings located on said lot do not encroach or project on adjacent street or property, and that no adjacent walls or buildings encroach or project on said premises, and no power lines cross this property except as shown hereon.

APR 24 1984

33261

10-0-42

R. L. Bruce, RLS #1952

Recordable Plat

CAROLINA SURVEYING CO.
112 Manly St.
Greenville, S. C.

87/22