MICROFILMED

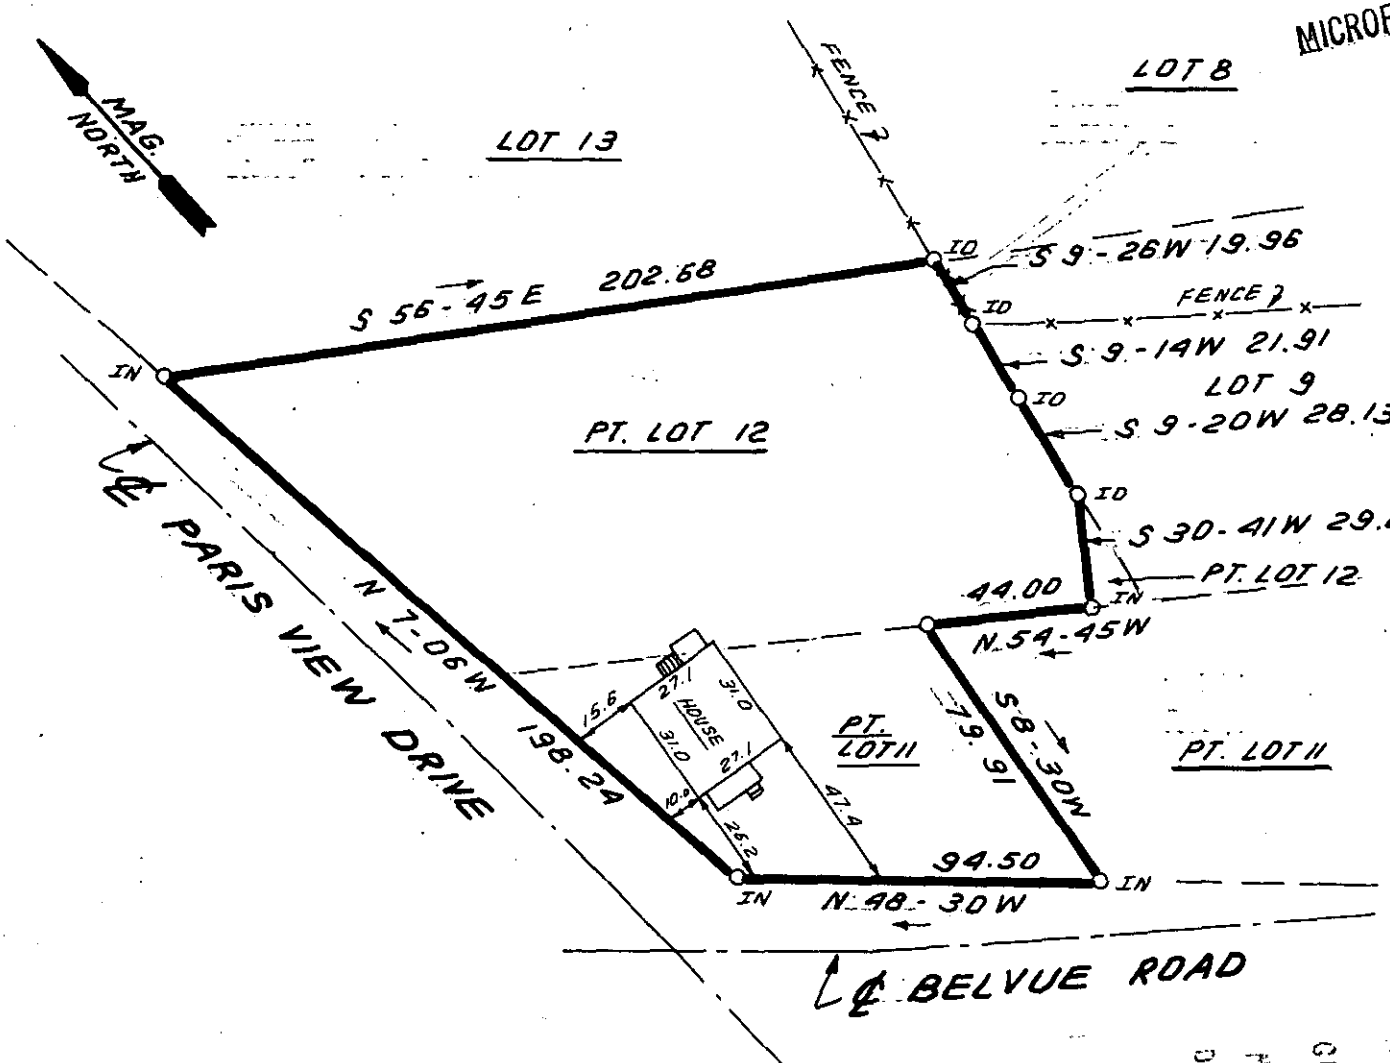

FILED
GREENVILLE CO. S.C.
MAY 14 11 57 AM '84
DONNIE S. TANKERSLEY
R.M.C.

35670

5D 0 5D 150
SCALE: 1" = 50 FEET

V10-P-40

THIS IS TO CERTIFY THAT THE PROPERTY SHOWN ON THIS PLAT WAS SURVEYED UNDER MY DIRECT SUPERVISION. PROPERTY LINES AND IMPROVEMENTS SHOWN ARE LOCATED CORRECTLY AND THAT NO VISIBLE ENCROACHMENTS EXIST UNLESS OTHERWISE SHOWN. THIS PROPERTY IS NOT LOCATED IN A DESIGNATED FLOOD HAZARD AREA.

SOUTH CAROLINA REGISTERED LAND SURVEYOR 4781 JAMES R. FREELAND

RLS: JAMES R. FREELAND
NO: 4781

STATE OF SOUTH CAROLINA
GREENVILLE COUNTY

PARIS VIEW ESTATES
PT. LOT 11 & PT. LOT 12
PROPERTY OF
CALVIN WEBB
POLLY WEBB

FREELAND & ASSOCIATES
Engineers • Land Surveyors
318 WEST STONE AVENUE.
GREENVILLE, S.C.
(803) 271-4924

PLAT BOOK	O - 193
DEED BOOK	577 - 55
TAX MAP	P 33.1-1-35.1 & 36.1
PARTY CHIEF	B.C.
DRAWN	B.R
DATE	5-10-84
DWG. NO.	11,075

THE PRINT MACHINE, INC. N37703

SCTC — 1 MY 14 84 238 3.00CT