


FILED  
GREENVILLE CO. S. C.  
MAY 21 11 18 AM '84  
BANKERSLEY  
R.M.C.

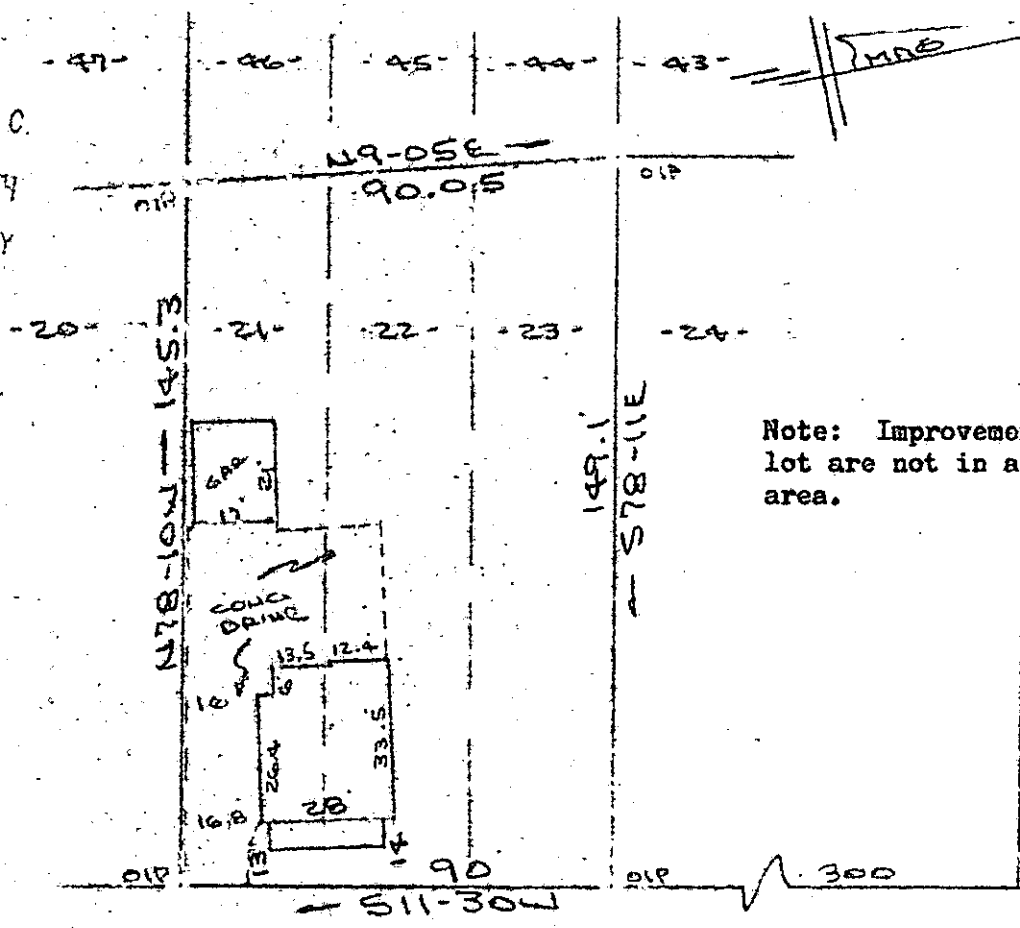


Note: Improvements on this lot are not in a flood hazard area.

HAWKINS STREET

MORROW AVENUE (STREET)  
WATER & SEWER IN ST. R/W

PROPERTY OF  
GARY KEITH PEANUFF  
GREENVILLE COUNTY, GREEN, S.C.  
23 MAY 1984

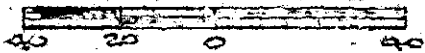


This is to certify that on the 23rd day of May, 1984, I surveyed the property shown on this plat, being known as lots 21, 22 & 23 on plat of MORROW PARK and recorded in the RMC Office Greenville County, S. C., in Plat Book " E " at Page 91; and that the property lines, walls and buildings are as shown hereon, and that the walls and buildings located on said lot do not encroach or project on adjacent street or property, and that no adjacent walls or buildings encroach or project on said premises, and no power lines cross this property except as shown hereon. Also known as PROPERTY OF GARY KEITH PEANUFF and recorded in Plat Book at Page

10-P-95

R. B. Bruce, RLS #1952

MAY 24 1984

37071 ✓

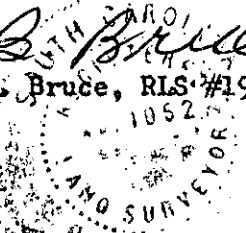

CAROLINA SURVEYING CO.  
112 Manly St.  
Greenville, S. C.

Recordable Plat

2 MY24 84 815

3.00CI