


MICROFILMED

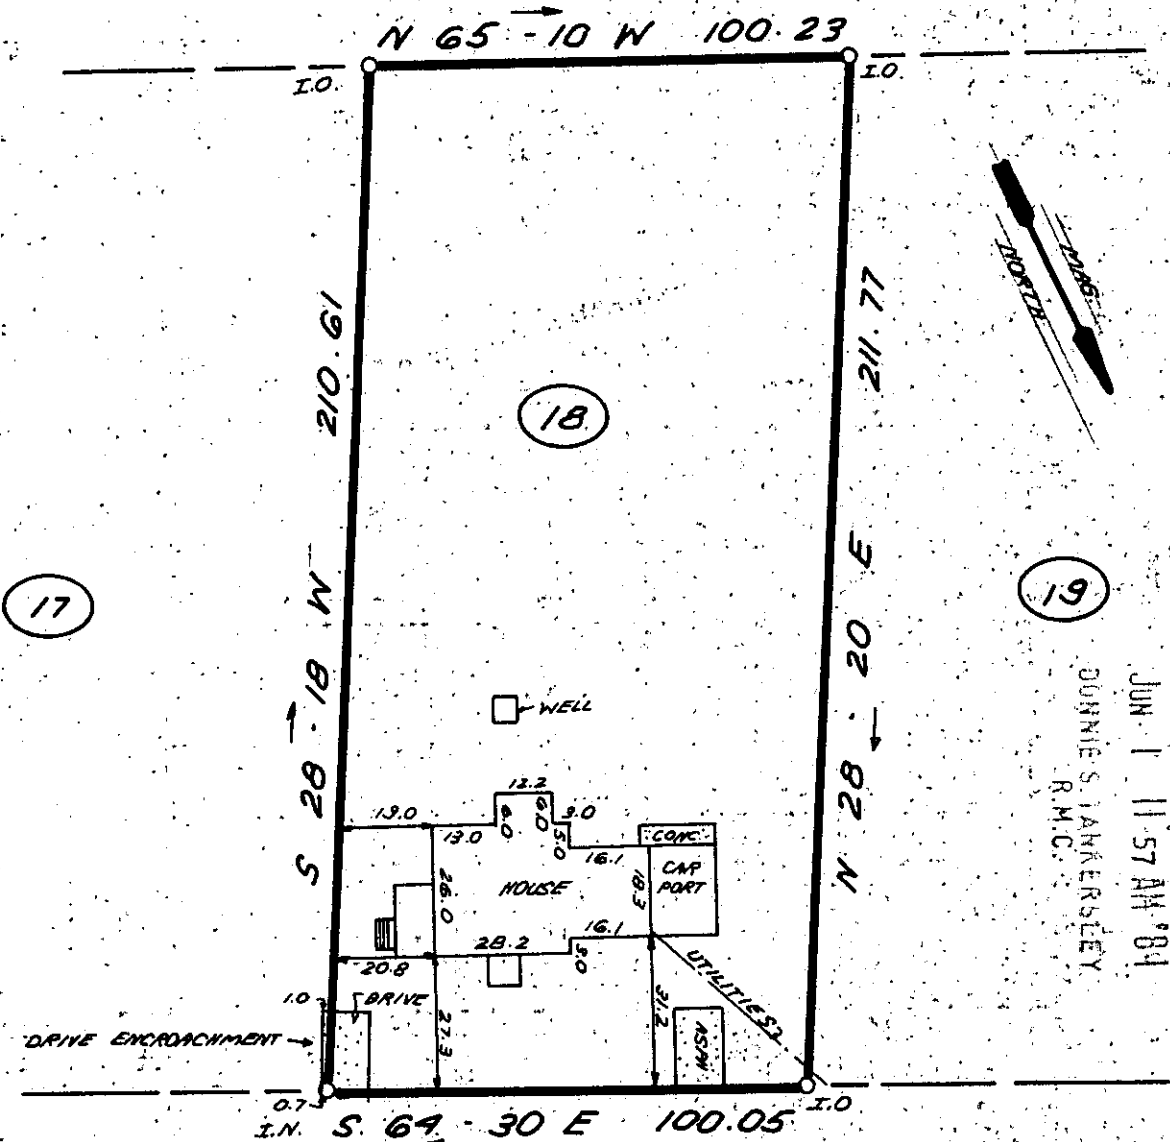

19

17

18

DUNNIE S. JANKERBLEY
R.M.C.


JUN 1 11:57 AM '84

FILED
GREENVILLE CO. S.C.

BUNCOMBE ROAD

196.8' TO
RUTHERFORD RD.

JUN 1 1984

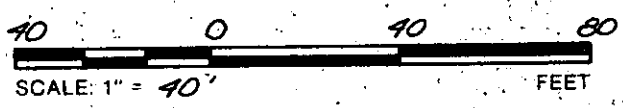

10-R-47 ✓

38113

THIS IS TO CERTIFY THAT THE PROPERTY SHOWN ON THIS PLAT WAS SURVEYED UNDER MY DIRECT SUPERVISION. PROPERTY LINES AND IMPROVEMENTS SHOWN ARE LOCATED CORRECTLY AND THAT NO VISIBLE ENCROACHMENTS EXIST UNLESS OTHERWISE SHOWN. THIS PROPERTY IS NOT LOCATED IN A DESIGNATED FLOOD HAZARD AREA.

STATE OF SOUTH CAROLINA
GREENVILLE COUNTY

FREELAND & ASSOCIATES
Engineers • Land Surveyors
318 WEST STONE AVENUE
GREENVILLE, S.C.
(803) 271-4924

R. A. FORD PROPERTY
LOT 18
PROPERTY OF
LISA D. MCKINNON

PLAT BOOK	0-63
DEED BOOK	1122-836
TAX MAP	T-9-3-1-2
PARTY CHIEF	L.T.
DRAWN	K.E.G.
DATE	MAY 31, 1984
DWG. NO.	11, 202



RES: JAMES R. FREELAND
NO: 4781

mcc