


FILED
GREENVILLE CO. S.C.
JUN 21 11 10 AM '84
DONNIE S. TANKERSLEY
R.M.C.

21

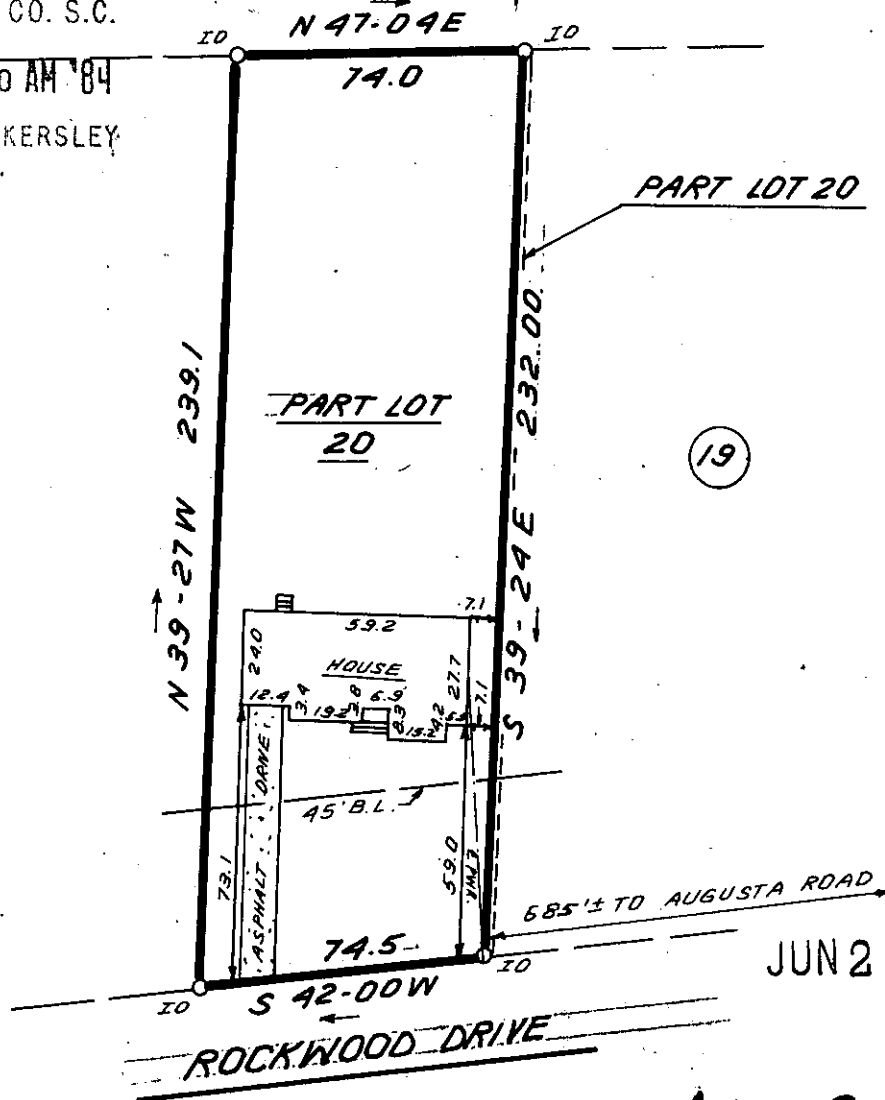

JUN 21 1984

10-S-25

40336



THIS IS TO CERTIFY THAT THE PROPERTY SHOWN ON THIS PLAT WAS SURVEYED UNDER MY DIRECT SUPERVISION. PROPERTY LINES AND IMPROVEMENTS SHOWN ARE LOCATED CORRECTLY, AND THAT NO VISIBLE ENCROACHMENTS EXIST UNLESS OTHERWISE SHOWN. THIS PROPERTY IS NOT LOCATED IN A DESIGNATED FLOOD HAZARD AREA.

58

SOUTH CAROLINA
REGISTERED LAND SURVEYOR
4781

JAMES R. FREELAND

RLS. JAMES R. FREELAND

NO: 4781

STATE OF SOUTH CAROLINA
GREENVILLE COUNTY

ROCKWOOD PARK
PART LOT 20
PROPERTY OF
ENZEL D. COTHRAN

FREELAND & ASSOCIATES
Engineers • Land Surveyors
318 WEST STONE AVENUE.
GREENVILLE, S.C.
(803) 271-4924

PLAT BOOK	214-3-27
DEED BOOK	1147-163
TAX MAP	B & - 37
PARTY CHIEF	B.C.
DRAWN	B.R.
DATE	6-14-84
DWG. NO.	11,279