

PEACE-HAGOOD ASSOCIATES

U 35-40W
B1.99

PARKING AREA

N 54-40 E

UNIT 2

UNIT 1

S 35-ACE


N/E VIRGINIA M & ROSE T MOORE

MAY 19 67

AUGUSTA STREET

Note:


Improvements on this lot are not in a flood hazard area.

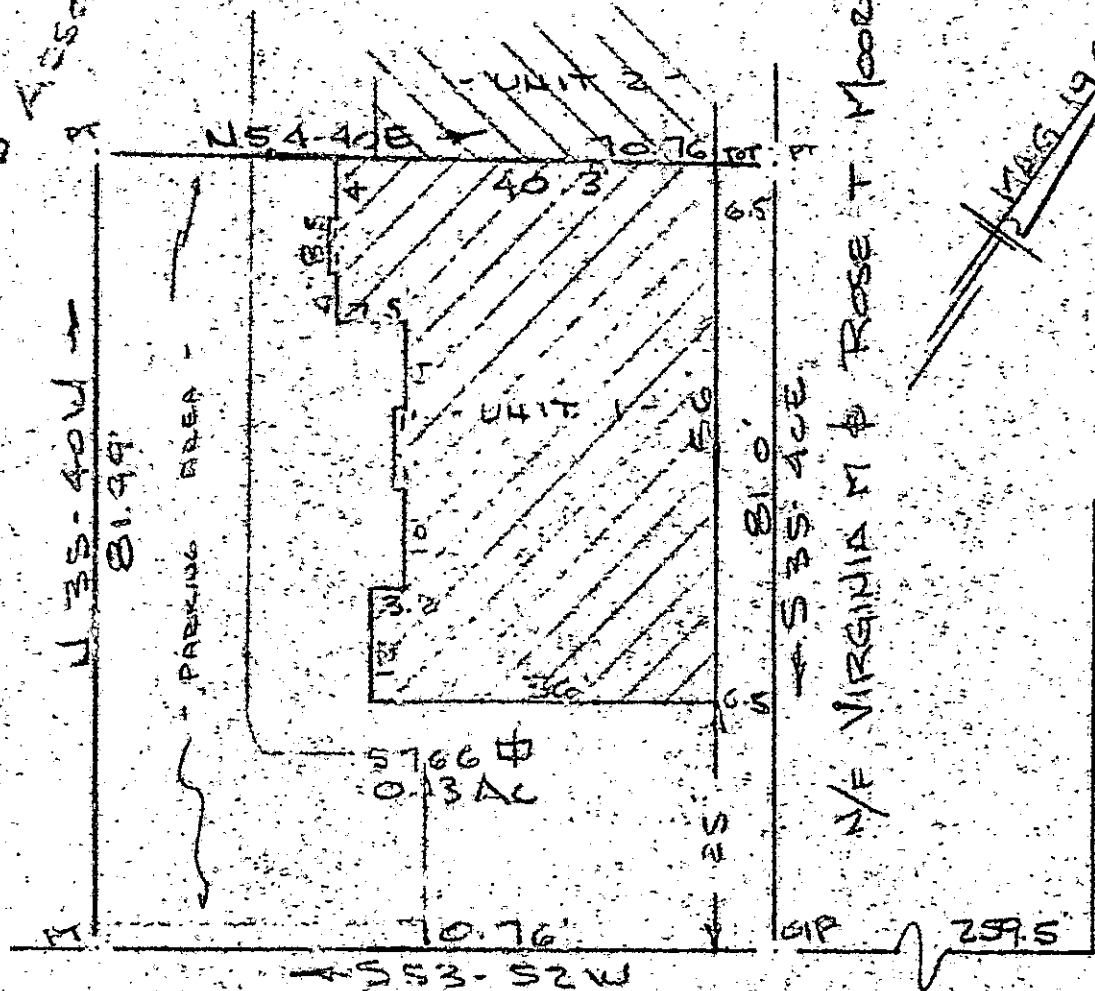

FILED
GREENVILLE CO. S.C.
JUN 27 10:23 AM '84
DONNIE S. TANKERSLEY
R.M.C.

MILLS AVENUE (BUSINESS HWY 29)
WATER & SEWER IN ST. RW

PROPERTY OF
RICHARD G. JACQUES, DDS
GREENVILLE, GREENVILLE COUNTY, S.C.
SCALE: 1" = 20'
21 JUNE 1984

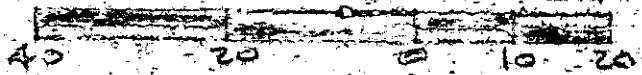

This is to certify that on the 21st day of June, 1984, I surveyed the property shown on this plat, being known as Unit 1 on plat of PROPERTY OF RICHARD G. JACQUES, DDS and recorded in the REC. Office Greenville County, S. C., in Plat Book " " at Page ; and that the property lines, walls and buildings are as shown hereon, and that the walls and buildings located on said lot do not encroach or project on adjacent street or property, and that no adjacent walls or buildings encroach or project on said premises, and no power lines cross this property except as shown hereon.

41001

10-5-48

R. B. Bruce
R. B. Bruce, RLS # 1982

JUN 27 1984

CAROLINA SURVEYING CO. Recordable Plat
112 Main St.
Greenville, S. C.

3 JUN 26 84 060 3.0600