


MICROFILMED

Notes This lot is not located in a flood prone area.

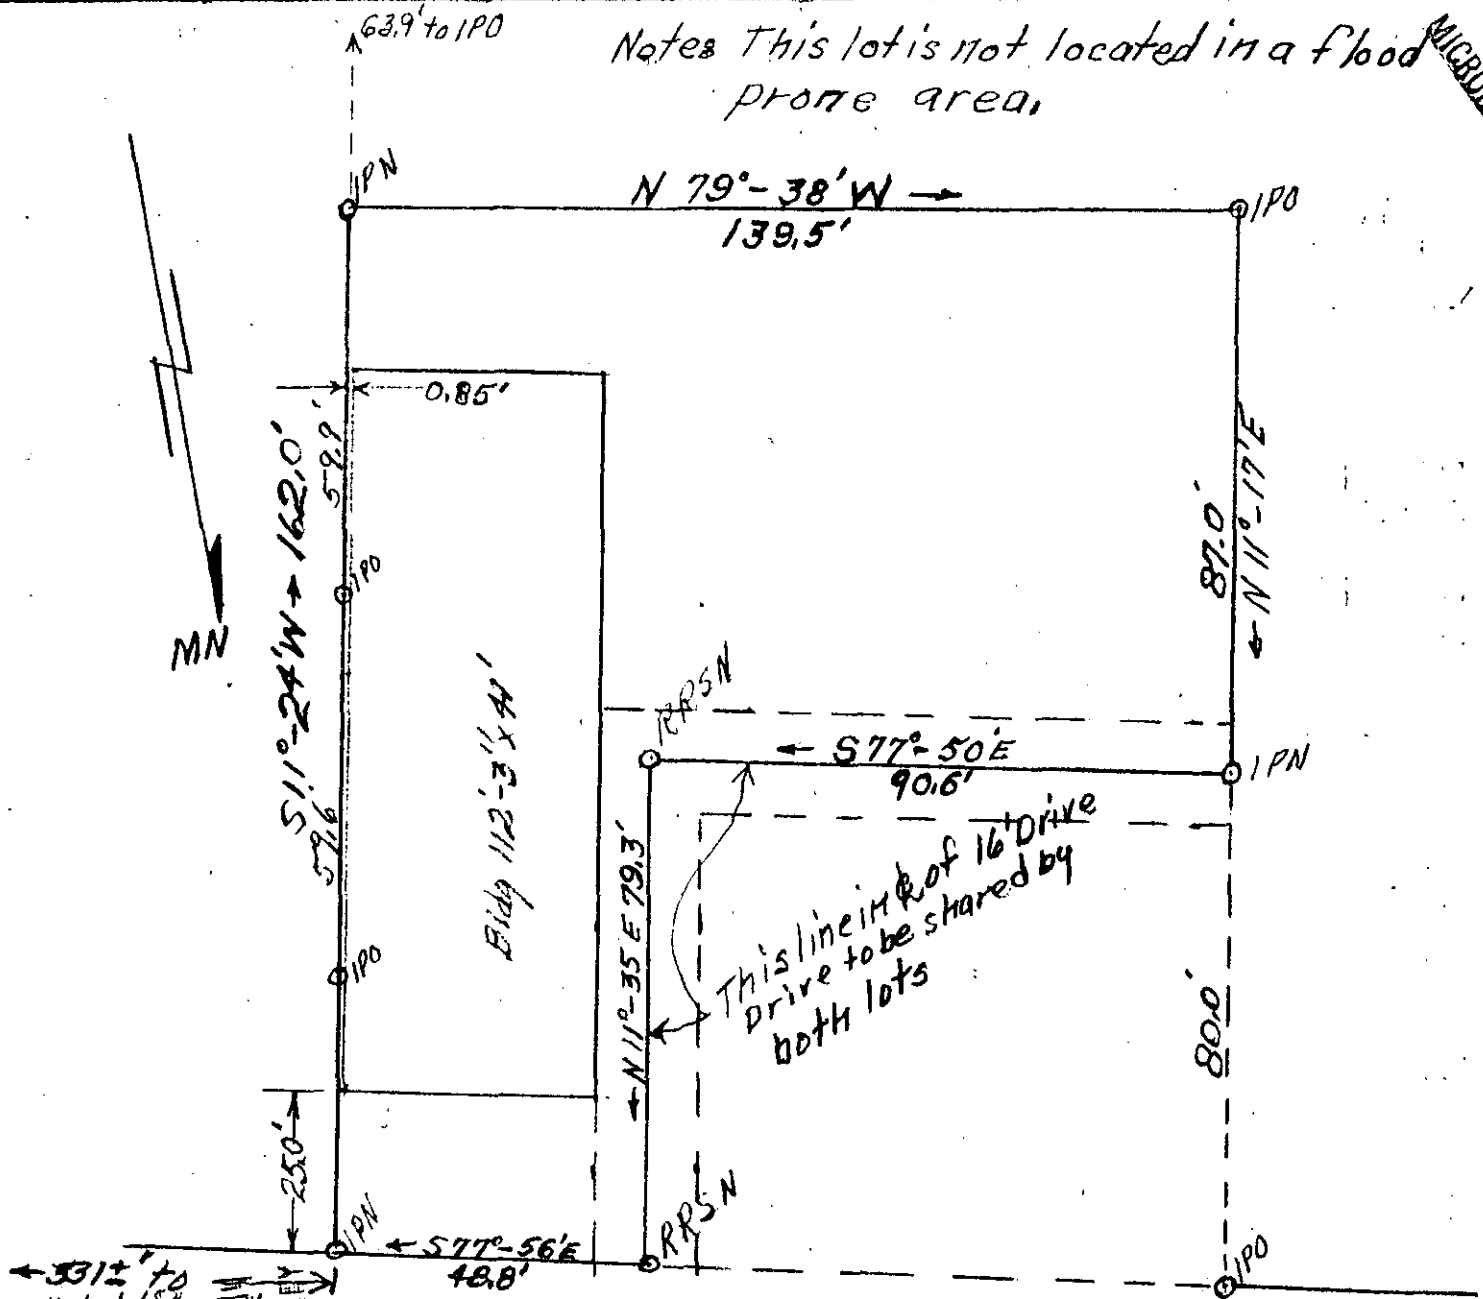

West Stone Avenue

FILED
 GREENVILLE CO.
 JUL 2 11 57 AM '84
 BONNIE S. TANKERSLEY
 R.M.C.

PLAT
for

10-5-69

177

EDWARD E. BROWER Jr. & CHARLOTTE L. BROWER

Located in Greenville, S.C

Scale: 1" = 30'

Surveyed by Alex A. Moss Reg. C.E. & L.S. No 1194

This is to certify that on 6/21/84 I surveyed the property shown. The building and walls do not encroach on the adjoining property and the building and wall on the adjacent property do not encroach on this except as shown.

6070 025
 Alex A. Moss

3.0000