


FILED  
GREENVILLE CO. S.C.  
JUL 3 9 25 AM '84  
DONNIE S. T. WARSLEY  
R.M.C.

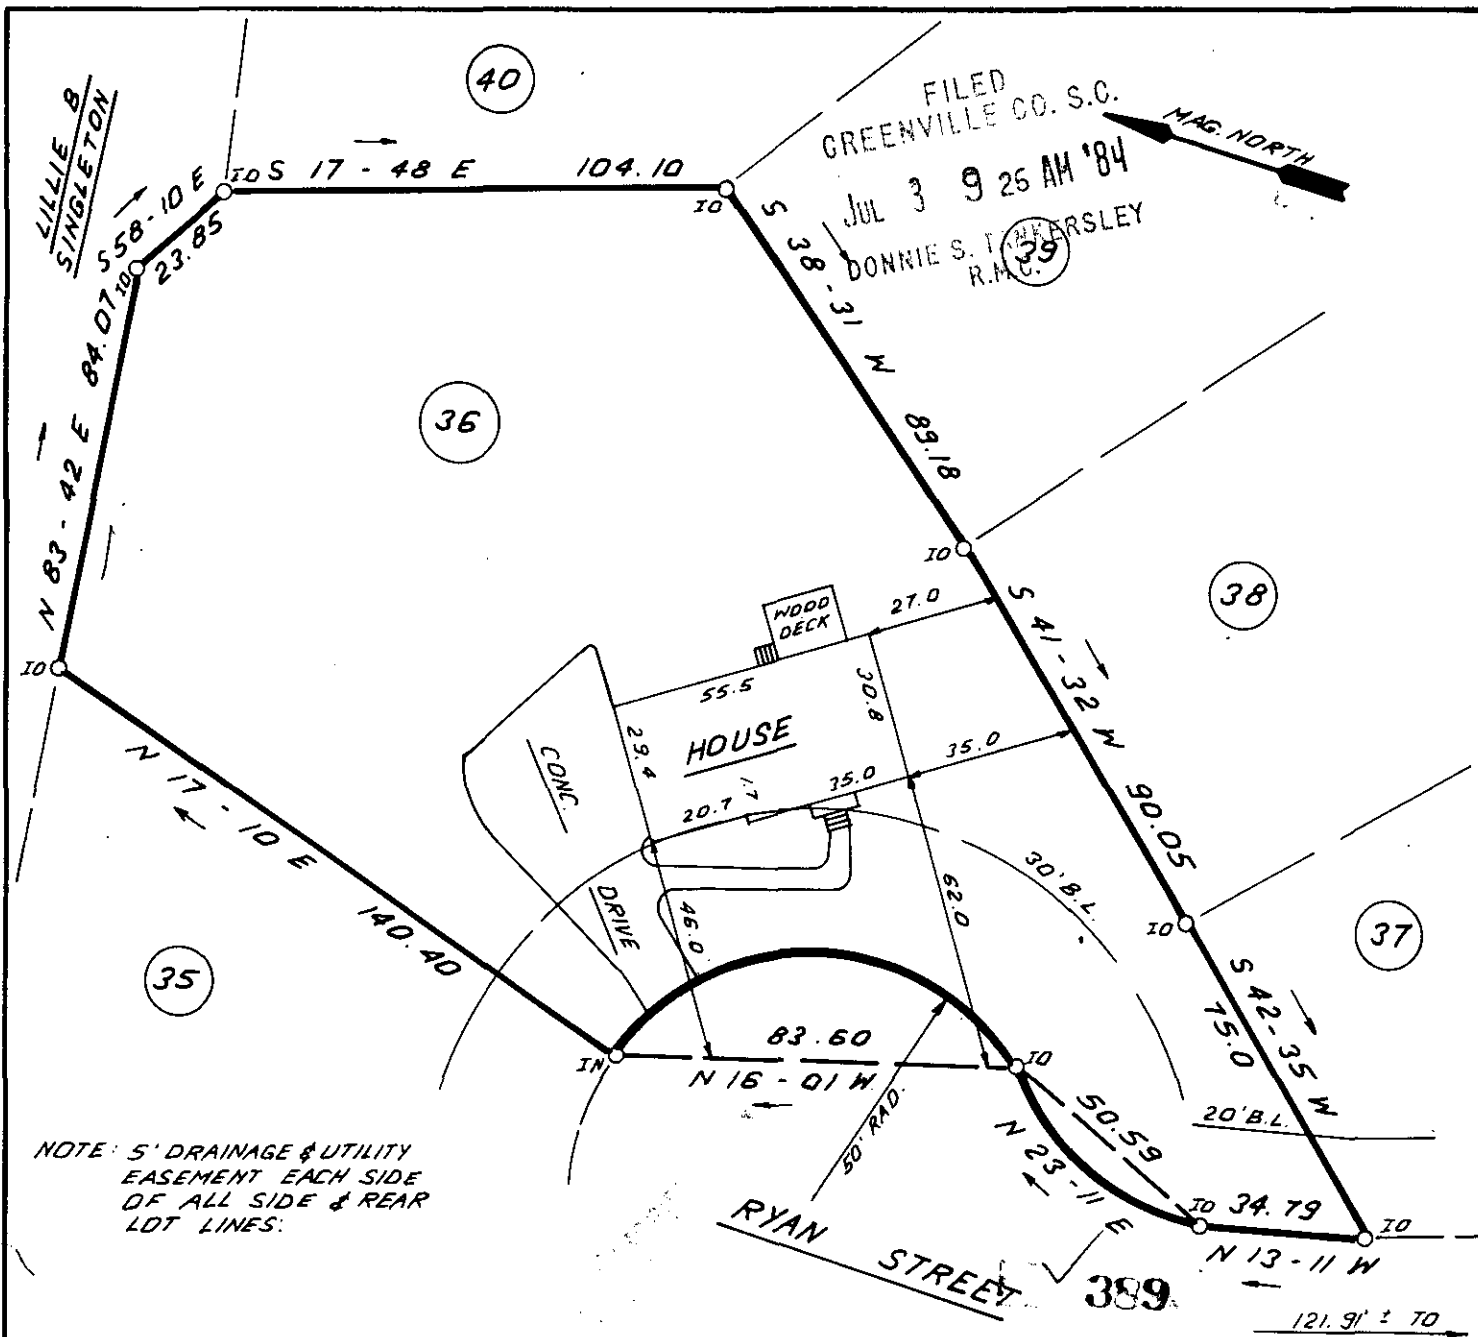

10-5-76 JUL 3 1984


NOTE: 5' DRAINAGE & UTILITY EASEMENT EACH SIDE OF ALL SIDE & REAR LOT LINES.



THIS IS TO CERTIFY THAT THE PROPERTY SHOWN ON THIS PLAT WAS SURVEYED UNDER MY DIRECT SUPERVISION PROPERTY LINES AND IMPROVEMENTS SHOWN ARE LOCATED CORRECTLY AND THAT NO VISIBLE ENCROACHMENTS EXIST UNLESS OTHERWISE SHOWN. THIS PROPERTY IS NOT LOCATED IN A DESIGNATED FLOOD HAZARD AREA.

300 3 21A01

SOUTH CAROLINA  
REGISTERED LAND SURVEYOR  
4781  
JAMES R. FREELAND

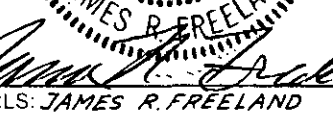

RLS: JAMES R. FREELAND  
NO: 4781

STATE OF SOUTH CAROLINA  
GREENVILLE COUNTY

EDWARDS FOREST  
SEC. 5; LOT 36  
PROPERTY OF  
R. KEITH GREENE  
MARY H. GREENE

FREELAND & ASSOCIATES  
Engineers • Land Surveyors  
318 WEST STONE AVENUE.  
GREENVILLE, S.C.  
(803) 271-4924

PLAT BOOK	AX-50
DEED BOOK	109-189
TAX MAP	525.5-1-9
PARTY CHIEF	B.G.
DRAWN	I.R.
DATE	6-25-84
DWG. NO.	// 358