


MICROFILMED

FILED  
GREENVILLE CO. S.C.


JUL 9 3 03 PM '84  
DANNIE S. TARKERSLEY  
R.M.C.

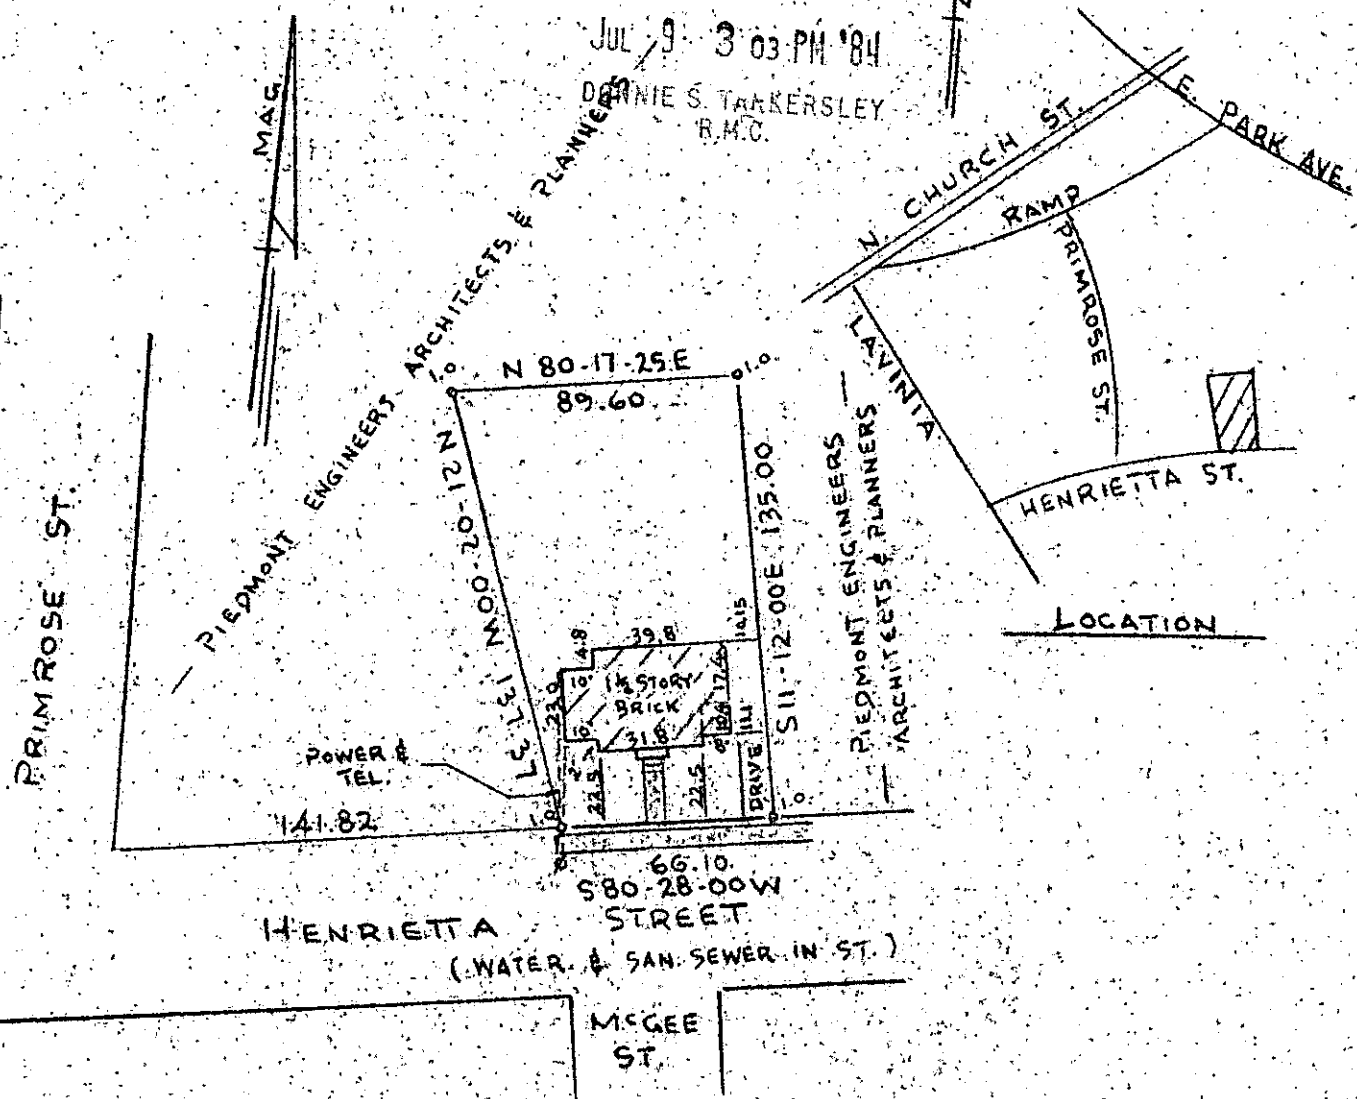

REC'D JUL 9 1984 1550

SURVEY FOR  
PIEDMONT ENGINEERS ARCHITECTS & PLANNERS  
GREENVILLE, S.C.

SCALE 1" = 60' JUNE 19, 1984

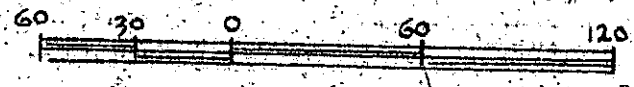

924 JUL 9 1984

I HEREBY CERTIFY THAT THE MEASUREMENTS AS SHOWN ARE CORRECT AND THERE ARE NO ENCROACHMENTS OR PROJECTIONS OTHER THAN SHOWN.

*James D. Cain*

R.L.S. No. 3320

SOUTH CAROLINA  
IRON PIN OLD LAND

PIEDMONT ENGINEERS - ARCHITECTS - PLANNERS  
GREENVILLE, S. C.

10-5-93