MICROFILMED

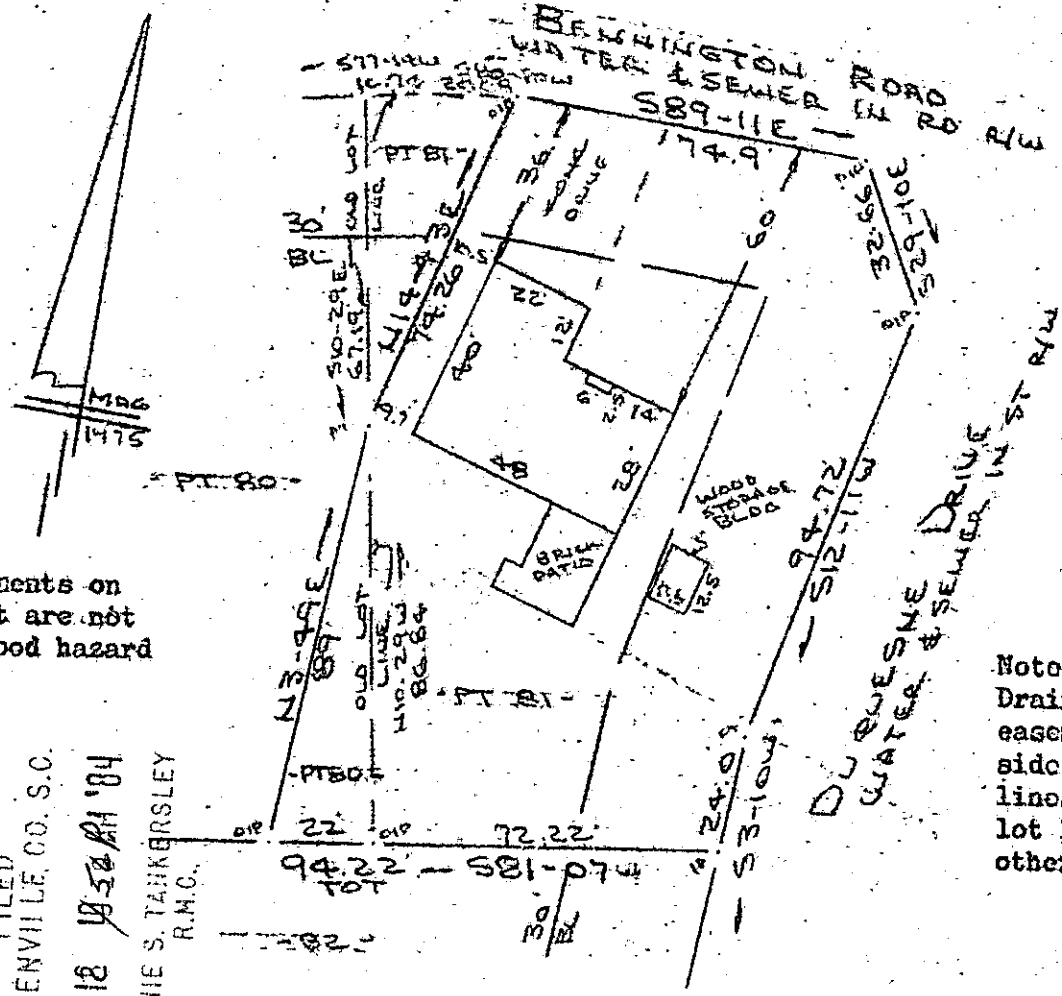

Note:
Improvements on this lot are not in a flood hazard area.

Note:
Drainage & utility easement 5 ' either side of all side lot lines, & 10 on rear lot lines except as otherwise noted.

FILED
GREENVILLE CO. S.C.
JUL 18 1984
DONNIE S. TANKERSLEY
R.M.C.

PROPERTY OF
JACOBUS J. LEENMAN & TRACY E. LEENMAN
NEAR GREENVILLE, GREENVILLE COUNTY, S.C.
SCALE: 1"=40' 9 JULY 1984

40 20 0 40

This is to certify that on the 9th day of July, 1984, I surveyed the property shown on this plat, being known as part of lot 80 and part of lot 81 on plat of CANEBRAKE I and recorded in the RMC Office Greenville County, S. C., in Plat Book " 5 - P " at Page 46; and that the property lines, walls and buildings are as shown hereon, and that the walls and buildings located on said lot do not encroach or project on adjacent street or property, and that no adjacent walls or buildings encroach or project on said premises, and no power lines cross this property except as shown hereon. Also known as PROPERTY OF JACOBUS J. LEENMAN & TRACY E. LEENMAN and recorded in Plat Book at Page

10-V-4

Recordable Plat

R. B. Bruce

R. B. Bruce, RLS # 1952

CAROLINA SURVEYING CO.
112 Manly St.
Greenville, S. C.

GCTO ----- 3 JL16 84 031 # 1421

3.00CD

534.4-1-81